

6.5 acres rrigation under C-33684
to be canceled
TS 35S-R1W-18 SWSE TL 170


18

SWSE

22



T.35S.R.1W.W.M.

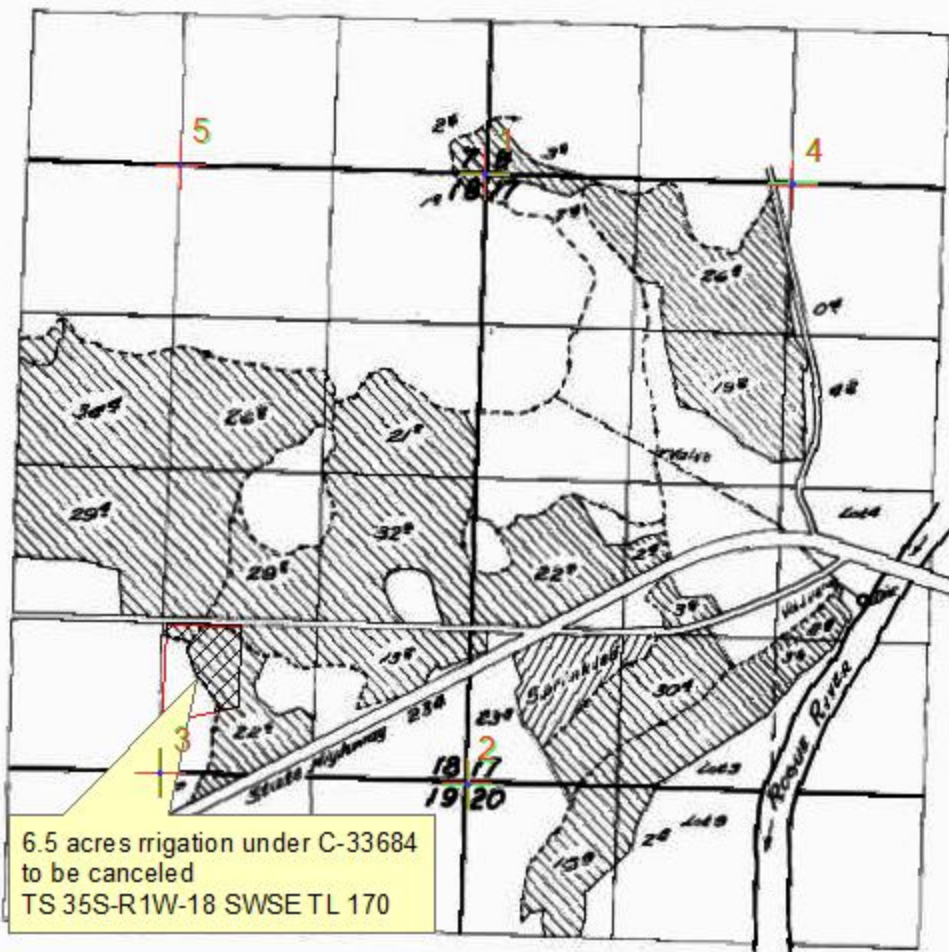

6.5 acres irrigation under C-33684
to be canceled
TS 35S-R1W-18 SWSE TL 170

**FINAL PROOF SURVEY
UNDER**

**APPL. NO. 197 PERMIT NO. 298
IN NAME OF**


B. L. DODGE

SURVEYED MAY 8, 12, 13, 1959 BY C. O. BOWEN

FOR ASSESSMENT AND TAXATION ONLY

SECTION 18 T.35S. R.1W. W.M.
JACKSON COUNTY
1" = 400'

35 1W 18

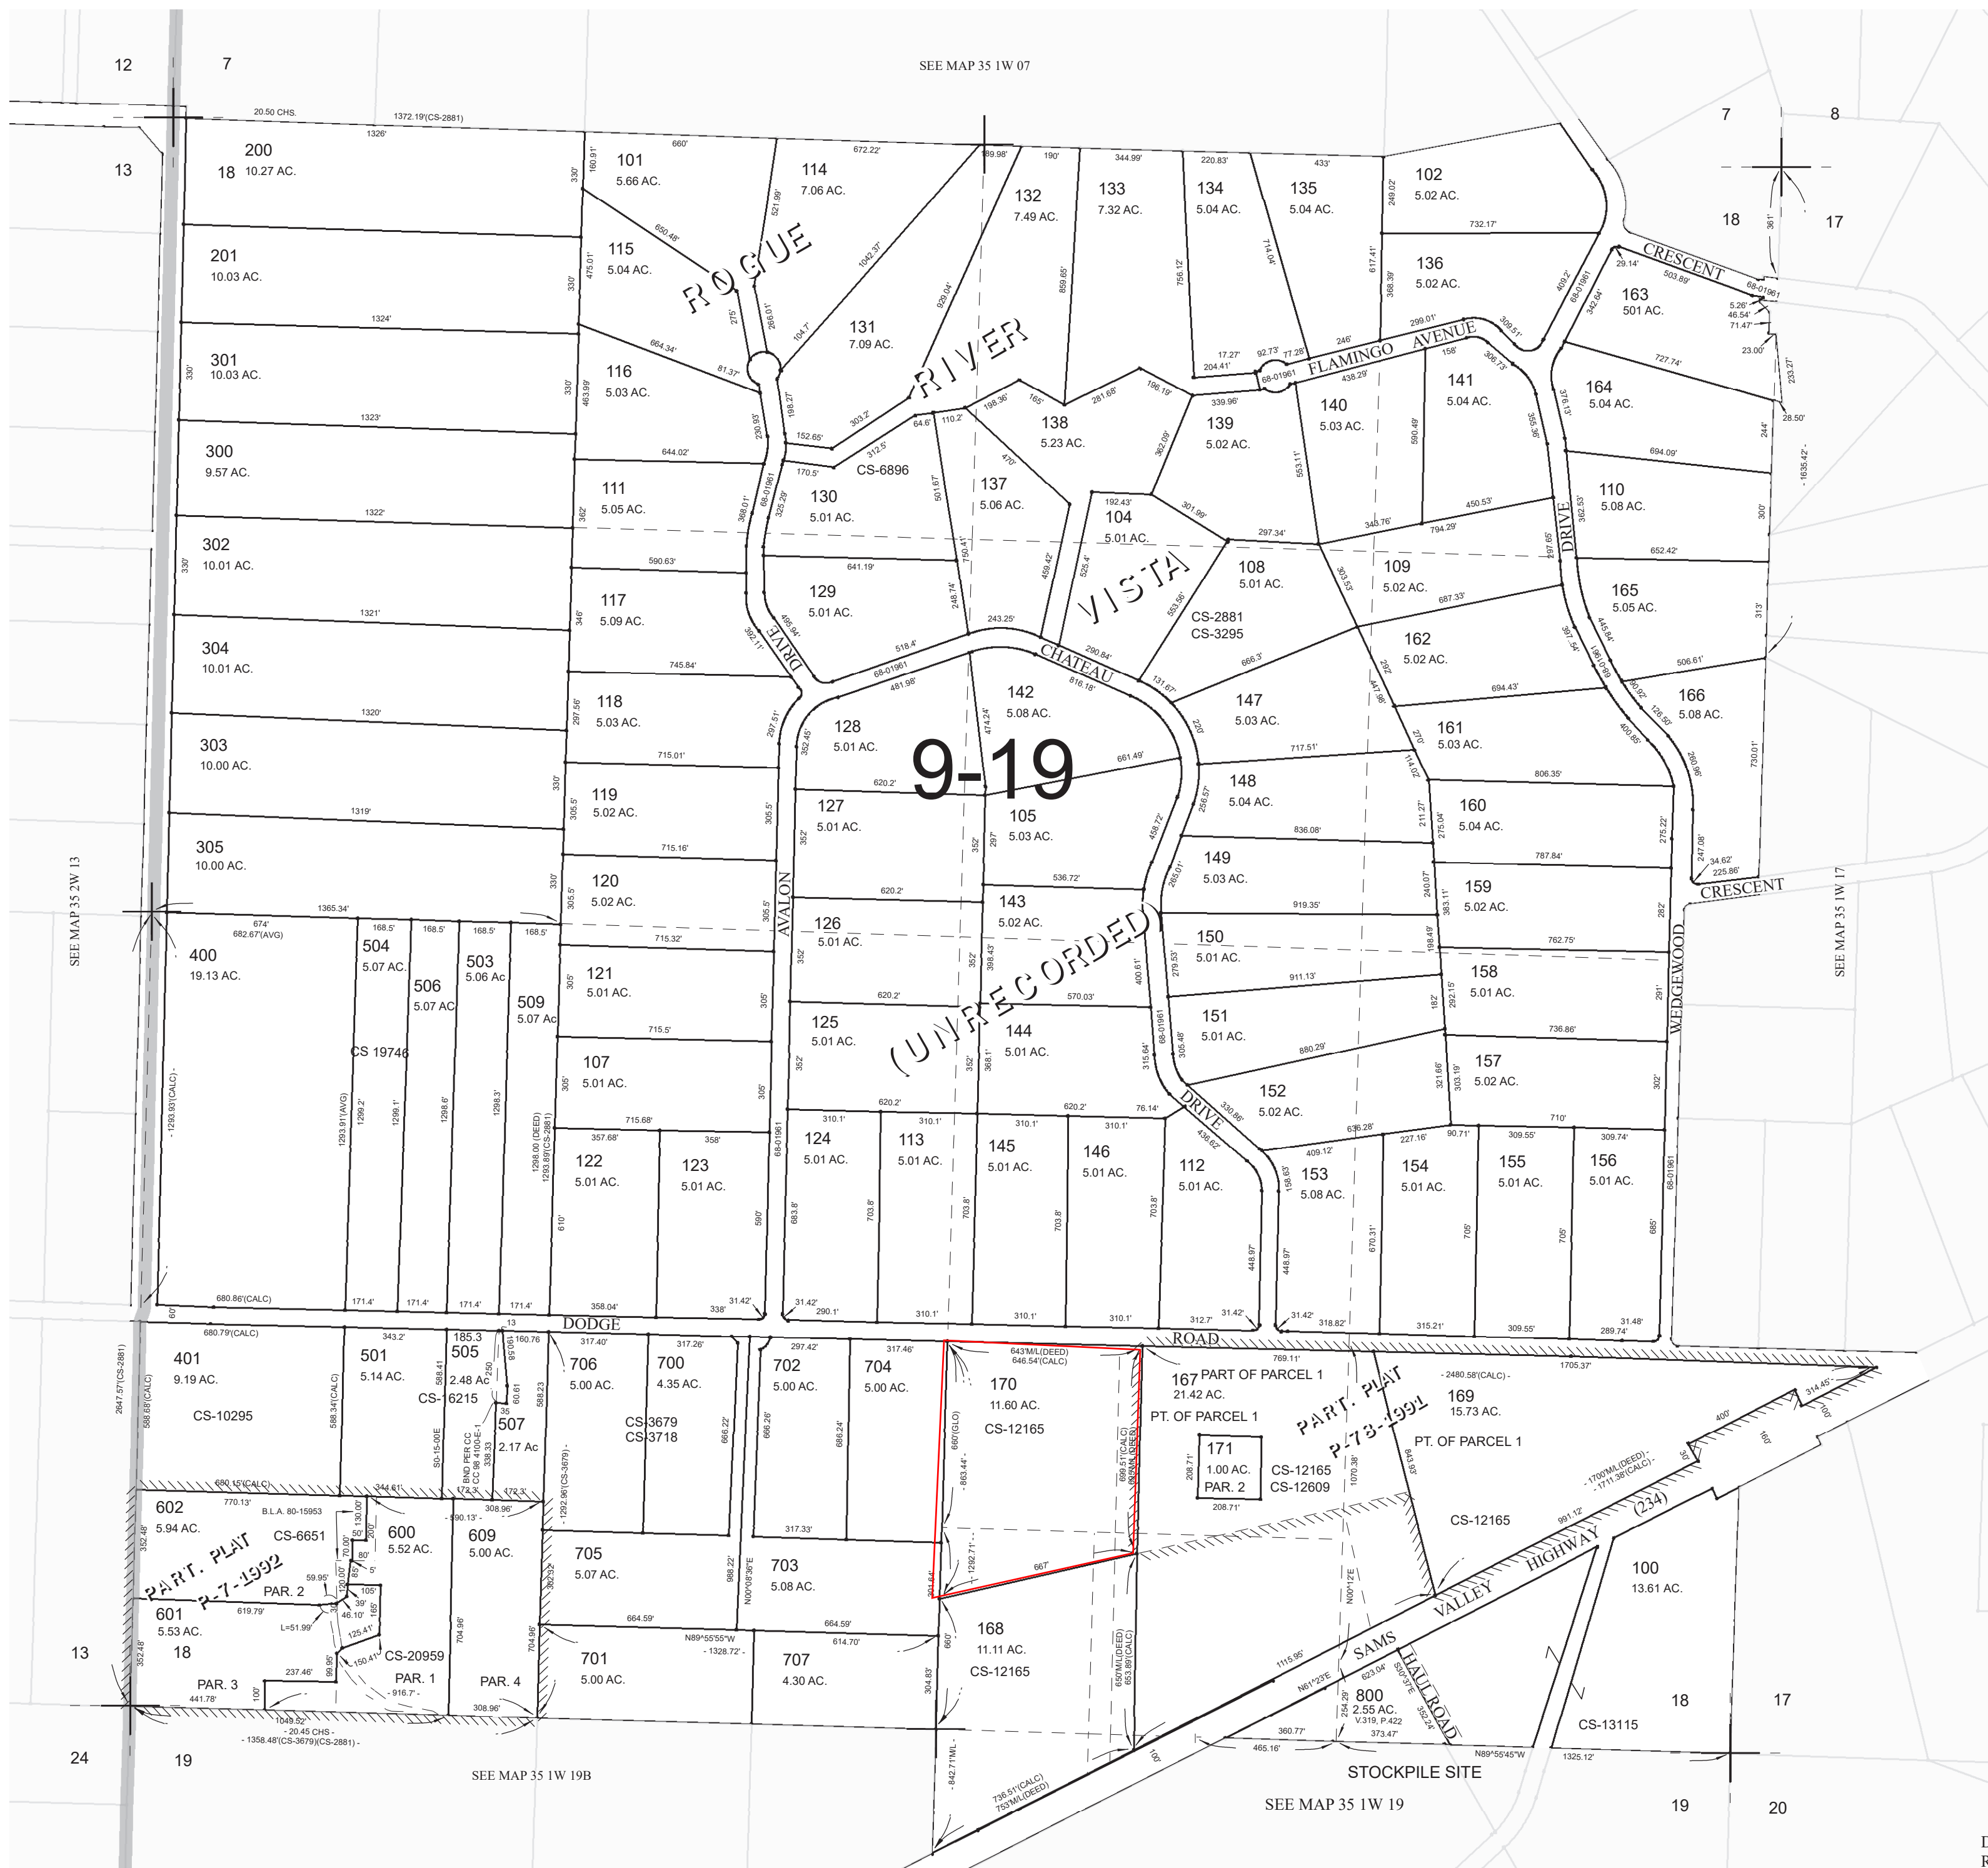

CANCELLED TAX LOT NUMBERS
502 ADDED TO 503
508 ADDED TO 505
603 ADDED TO 600
604 ADDED TO 601
605 ADDED TO 602
606 ADDED TO 602
607 ADDED TO 601
608 ADDED TO 602