


Cert # 67217

T. 8S. R. 39E. W.M.

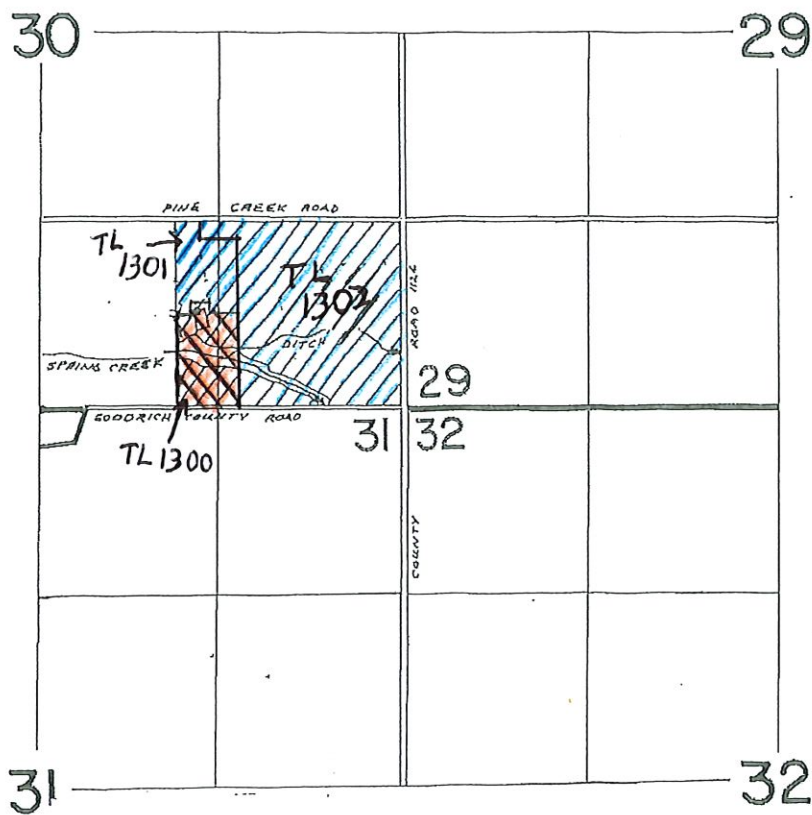

Scale
1" = 1320



To be Canceled
TL 1301 & 1302

5.24 ac SW, SE
33.9 ac SE, SE



Remaining Right
TL 1300

4.76 ac SW, SE
1.1 ac SE, SE

Received
DEC 02 2024

OWRD