


Cert #1860

T. 8S. R. 39E. W.M.

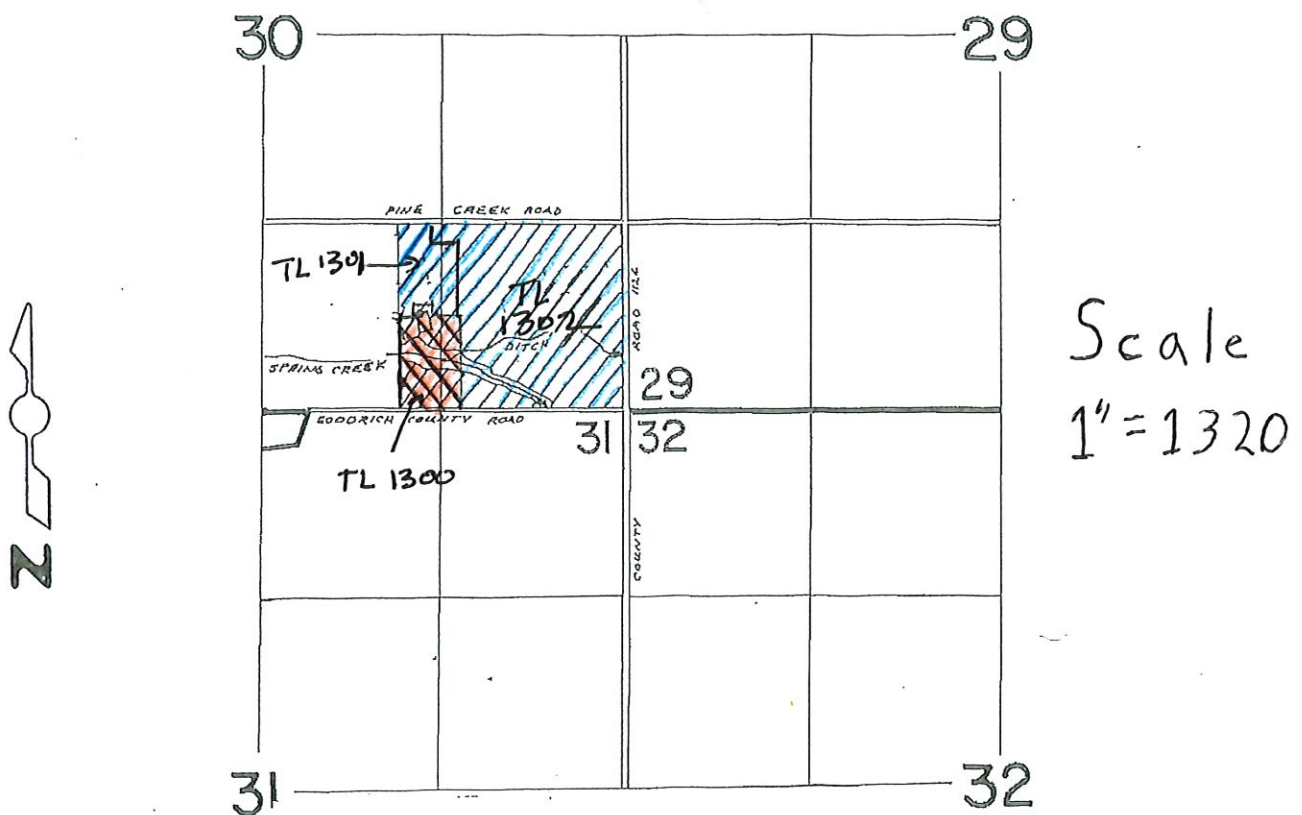

To be Canceled
TL 1301 ; TL 1302

5.24 SW, SE
38.9 SE, SE



Remaining Right
TL 1300

4.76 SW, SE
1.1 SE, SE

Received

DEC 02 2024

OWRD