


Cert# 45722

T. 8S. R. 39E. W.M.

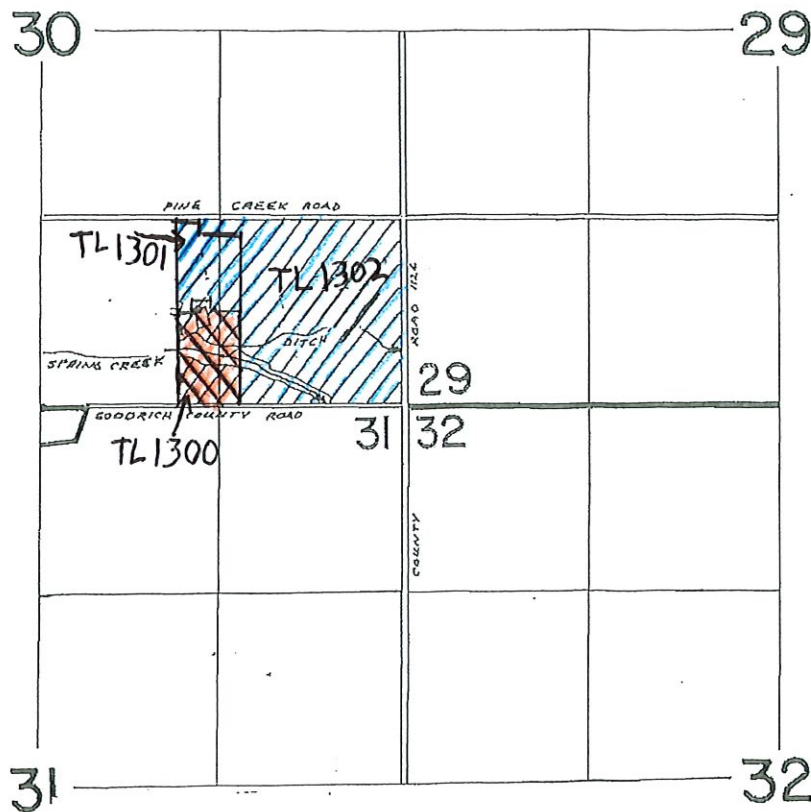

Scale
1" = 1320



To be Canceled 3.24 ac SW, SE
TL 1301 & 1302 34.4 ac SE, SE



Remaining Right 4.76 ac SW, SE
TL 1300 1.1 ac SE, SE

Received
DEC 02 2024
OWRD

Received
DEC 02 2024