


Well Location:
125' S, 60' E of NW Cor Sec 19

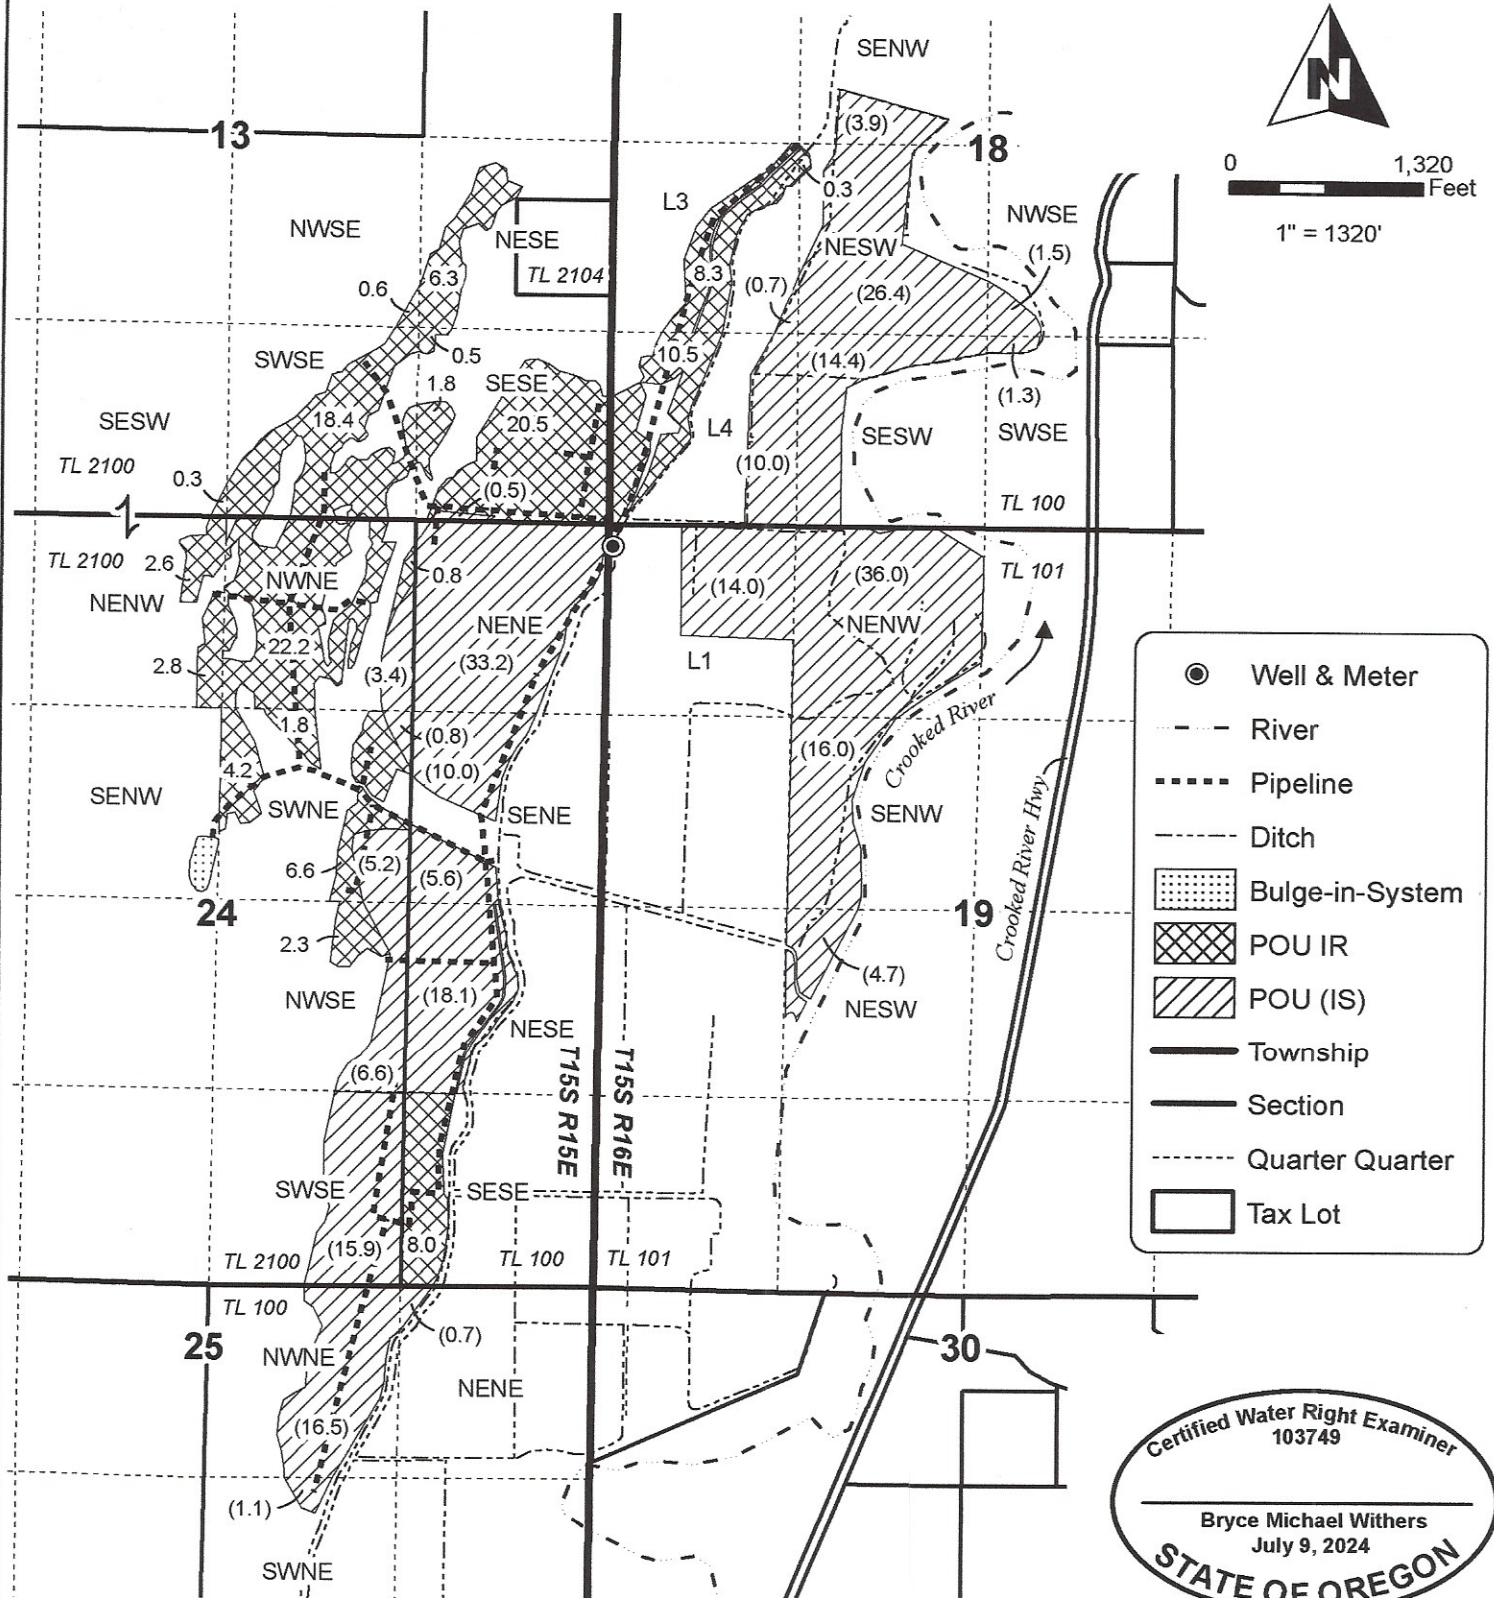

T15S R15E & T15S R16E, WM, CROOK COUNTY, OR



Certified Water Right Examiner
103749

Bryce Michael Withers
July 9, 2024

STATE OF OREGON

RENEWES: 06/30/2026

CLAIM OF BENEFICIAL USE MAP WHITE DEER RANCH #22073

Date: 9/23/2024 Ap G-14150 / T-11889 Permit G-18889

This map is not intended
to provide legal dimensions
or locations of property
ownership lines.

WATER RIGHT SERVICES, LLC

PO BOX 1830, BEND, OR 97709
WWW.OREGONWATER.US CCB # 197121
johnshort@usa.com 541-389-2837