


Received by OWRD

JUN 18 2024

Salem, OR

Section 9, T18S, R5W, W.M.,
Lane County, Oregon


CLAIM OF BENEFICIAL USE MAP
Application G-18385,
Permit G-17813
Michael Kirschnick

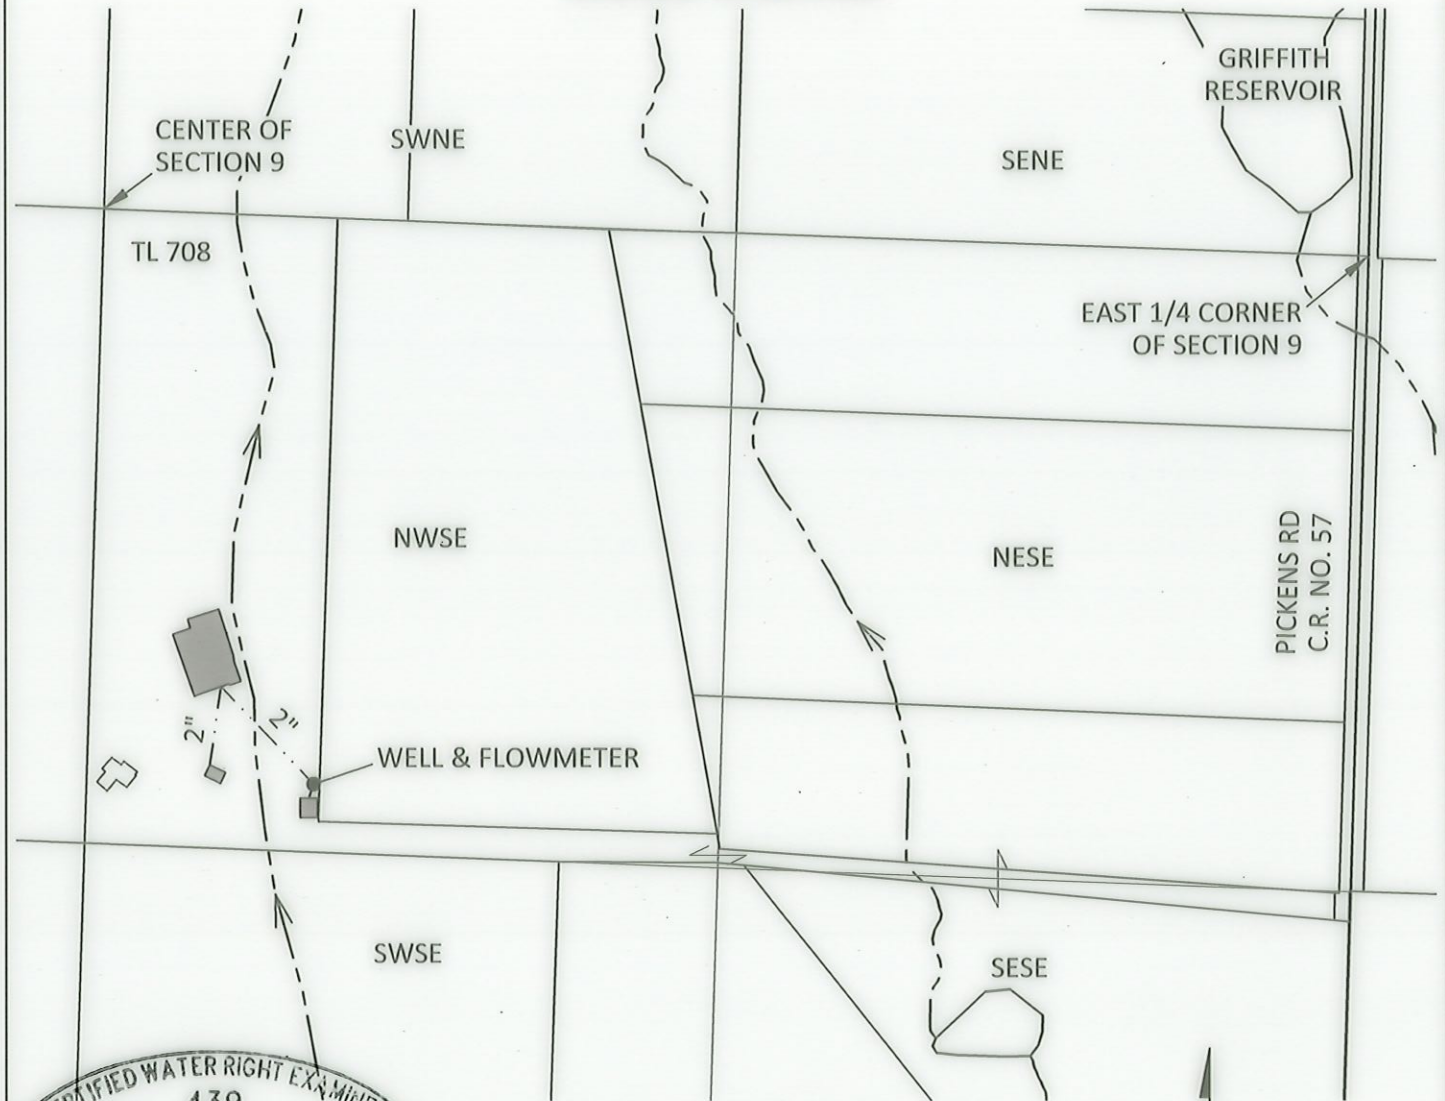

WELL LOCATION: 1,100 FT S AND 2,190 FT W FROM
EAST 1/4 CORNER OF SECTION 9,
T18S, R5W, W.M.

EXPLANATION

-  PLACE OF USE - NURSERY
0.4 ACRES
PRIORITY: 9/14/2016
-  WELL
-  PIPE

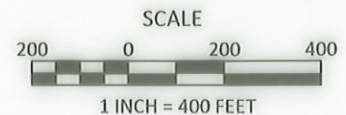

June 12, 2024

This map is not intended to provide legal
dimensions or locations of property
ownership lines

Figure 1

SKOOKUM
WATER ASSOCIATES INC

1626 VICTORIAN WAY
EUGENE, OR 97401
(503) 319-8926

Site Inspection Conducted
May 16, 2024