


SITUATED IN SECTIONS
9 & 16, TOWNSHIP 33 S
RANGE 2 E, W.M.
JACKSON COUNTY OR

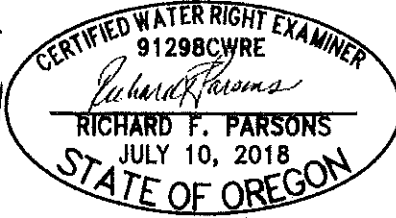

ParsonsWater Consulting LLC
rick.parsons@parsonwater.com
541.499.0257 303.667.5067