
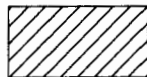


RECEIVED

RECEIVED BY OWRD

OCT 17 2014

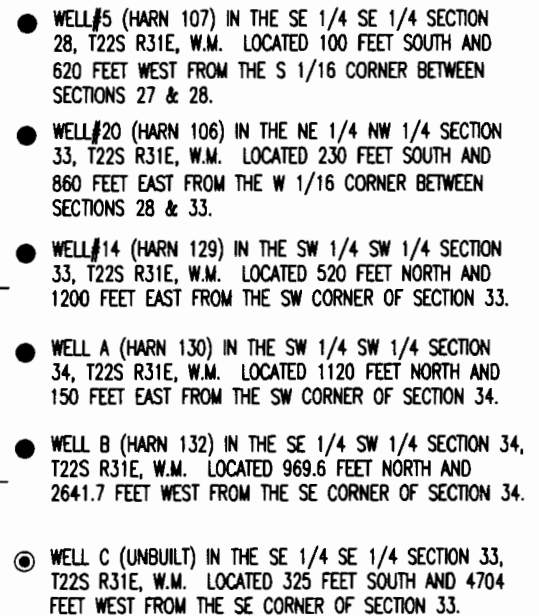

86.3 ACRES SUPPLEMENTAL RIGHTS FROM CERTIFICATE #36880
(G-2880) POU REMAINS, AS SHOWN. PROPOSE WELL 14
REPLACES WELL 20 & ADDITIONAL WELLS A, B, & C.

THIS MAP IS FOR THE PURPOSE OF LOCATING A WATER RIGHT ONLY AND HAS NO INTENT TO PROVIDE LEGAL DIMENSIONS OR THE LOCATION OF PROPERTY LINES.

P.O. BOX 767
TERREBONNE, OREGON 97760
(541) 548-5833 PH
(541) 585-4602 FX
www.APEandS.com