


11493

10488

SPRING WATER WORKS T. 10S. R. 6W. W.M.

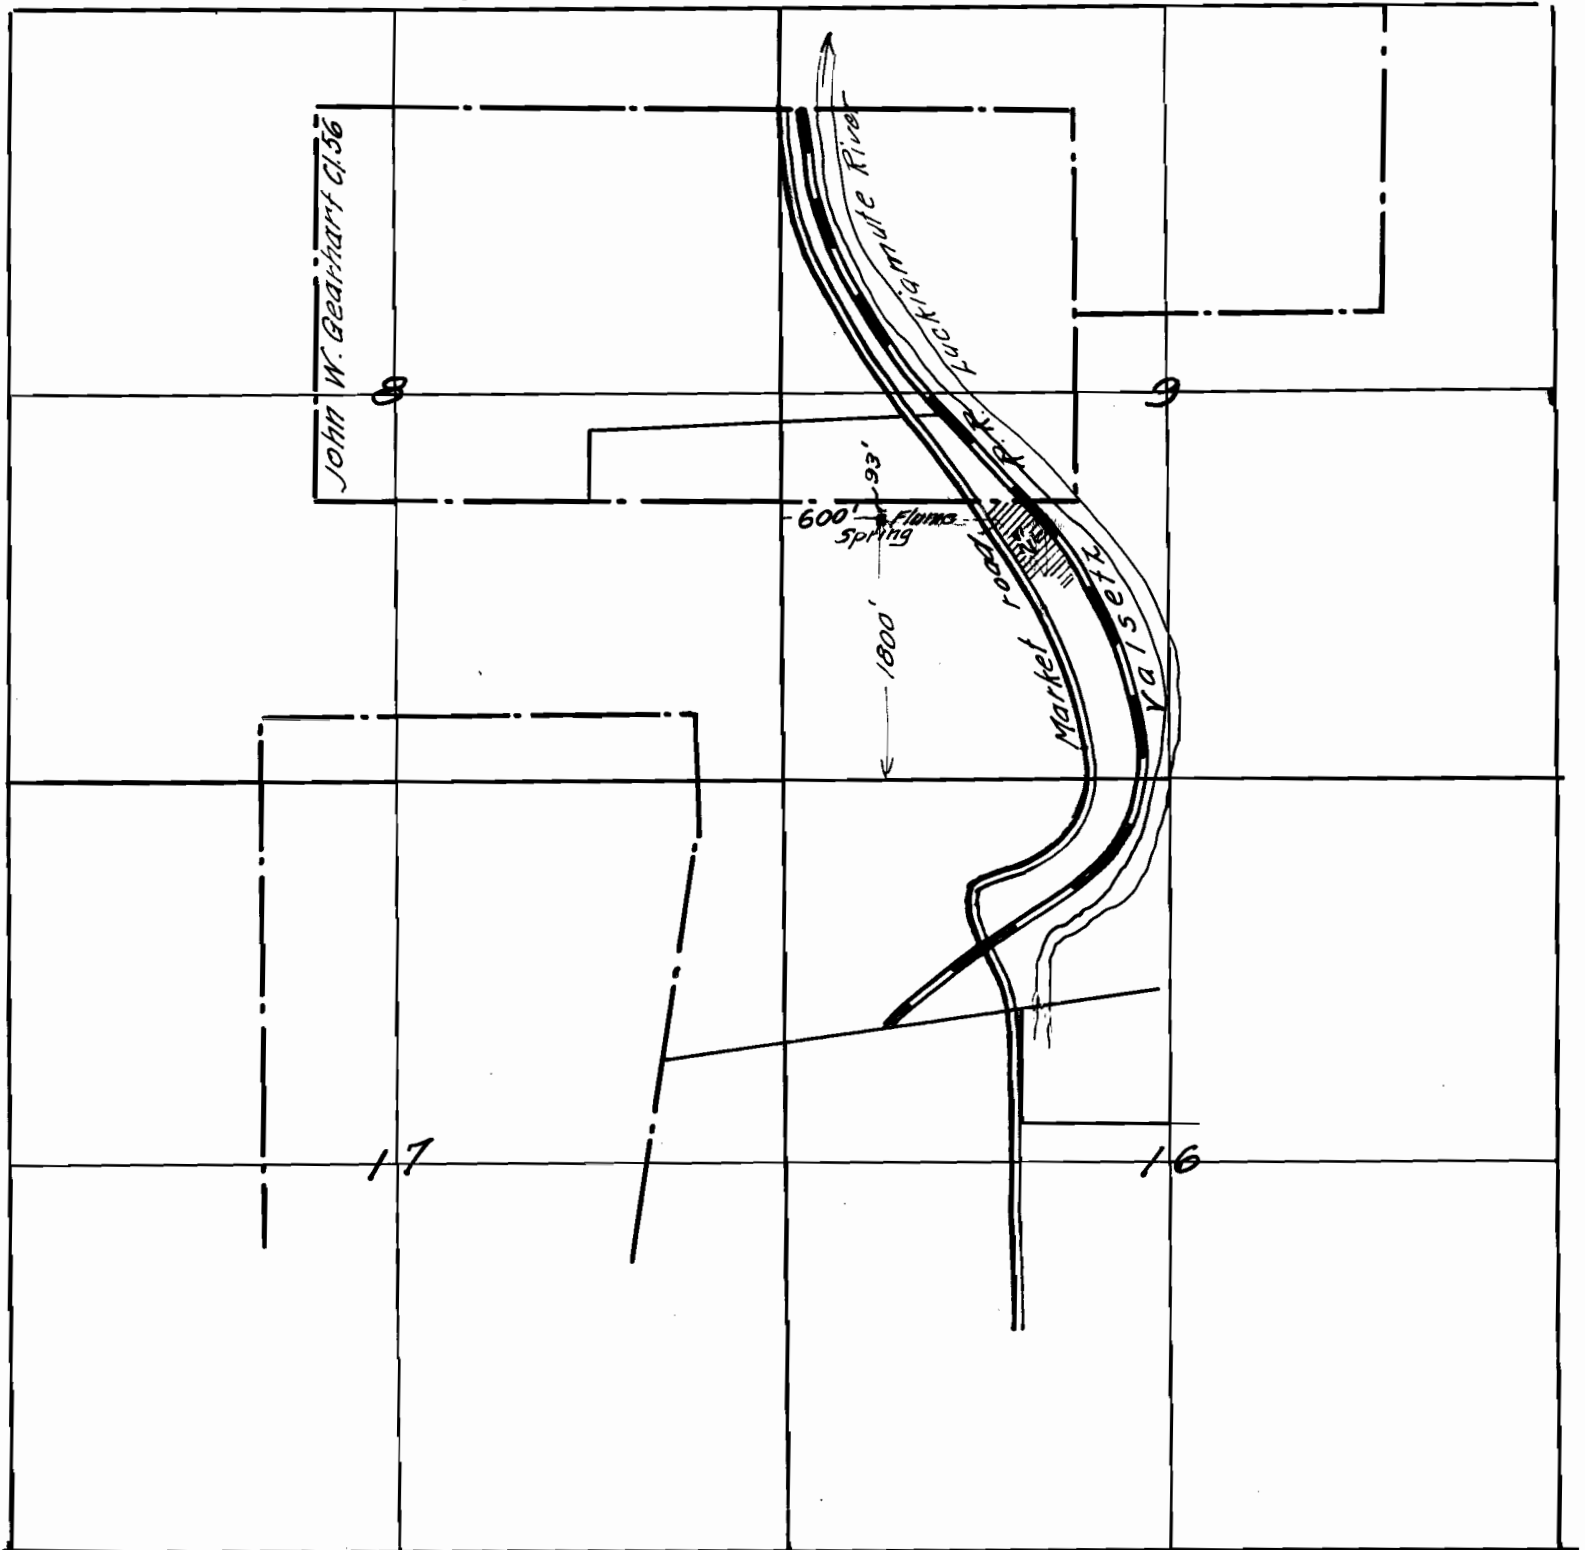

I, Walter W. Larsen, of Corvallis, Oregon, do hereby certify that this map was made from notes taken during an actual survey made by me and under my direction on and before May 1st, 1923, and that it correctly represents the works described in the accompanying application, together with the location of streams and other ditches in the immediate vicinity.

Walter W. Larsen
Registered Professional Engineer

Ore. No. 1261 May 11, 1923
Scale: - 4 inches = 1 Mile.