

RECEIVED

JUL 29 2022


OWRD

SURFACE WATER BENEFICIAL USE MAP

APPLICATION S-86298/PERMIT S-54491

4-25-19

T.26S., R.5W., WILLAMETTE MERIDIAN DLC NO. 47

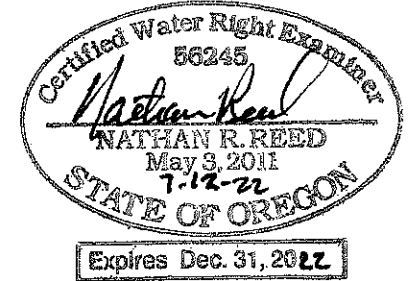



DATE SURVEYED 3-30-2022

RECEIVED

AUG 19 2022

OWRD

- WATERLINE
- 1/4 SECTION LINE
- 1/16 SECTION LINE
- DLC LINE
- DLC CORNER
- PUMP

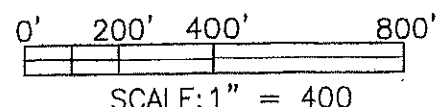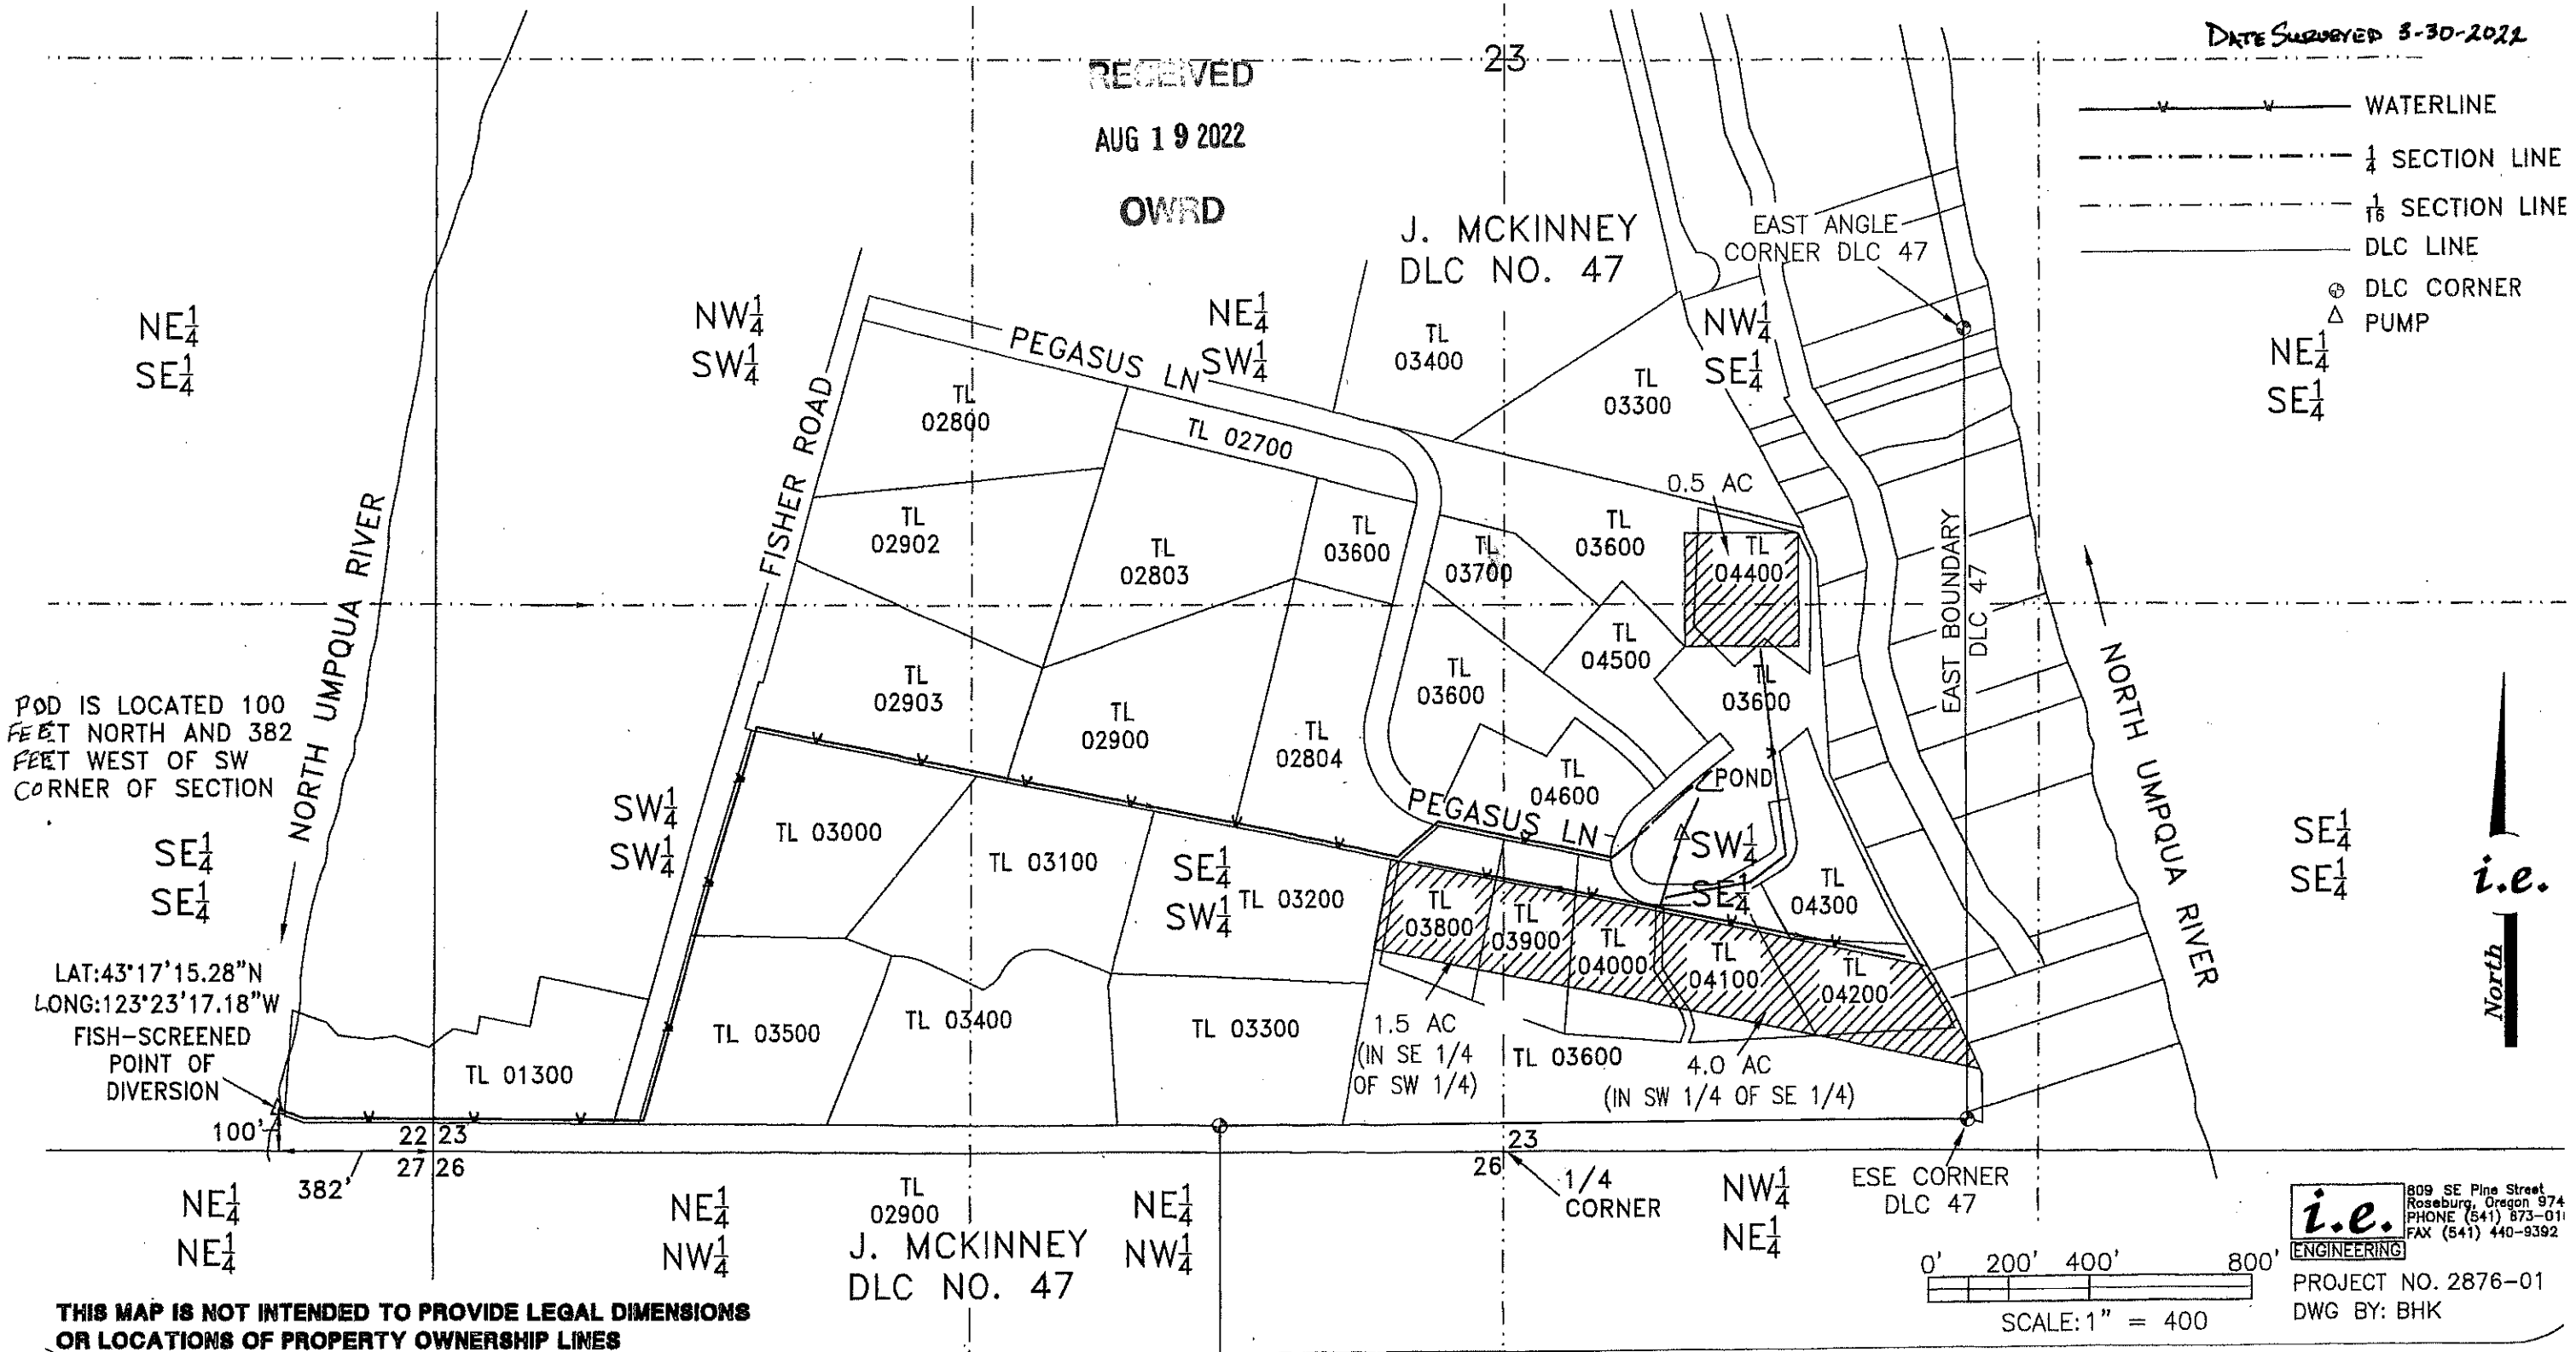

i.e. ENGINEERING
 809 SE Pine Street
 Roseburg, Oregon 974
 PHONE (541) 873-0111
 FAX (541) 440-9392
 PROJECT NO. 2876-01
 DWG BY: BHK

THIS MAP IS NOT INTENDED TO PROVIDE LEGAL DIMENSIONS OR LOCATIONS OF PROPERTY OWNERSHIP LINES