


Document Path: Y:\0566_McKibben\Source_Elourses\001_VMF_Consulting\COBU\andx.abamr

- LEGEND**
- ⊙ Center of Dam
 - Staff Gauge
 - ▨ Place of Use (POU)
 - Donation Land Claim (DLC)
 - ⊕ Tax Lot
 - ~ Watercourse

**Claim of Beneficial Use
in the Name of David McKibben and Lowell Ford
Place of Use/Point of Diversion Map
Permit R-13073, Application R-84588
Township 8 South, Range 5 West (W.M.)**

CERTIFIED WATER RIGHTS EXAMINER STAMP

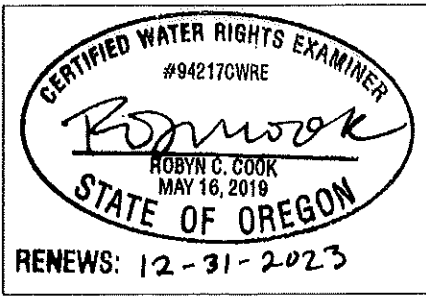

RECEIVED

SEP 02 2022

OWRD

LOCATION DESCRIPTION
Center of Dam
Located 640 feet South and 2010 feet West from the SE corner
of DLC 44, Township 8 South, Range 5 West (W.M.)

DISCLAIMER
This map was prepared for the purpose of
identifying the location of a water right only and
it is not intended to provide legal dimensions
or location of property ownership lines.

Date: July 28, 2022
Data Sources: BLM, ESRI, OWRD, USGS, Polk County

