


Claim of Beneficial Use
Application G-15743
T-12098
Permit G-17531
Maxwell Cattle Inc

T 27 S, R 22 E, WM
Section 11 & 12

T 27 S, R 22 E

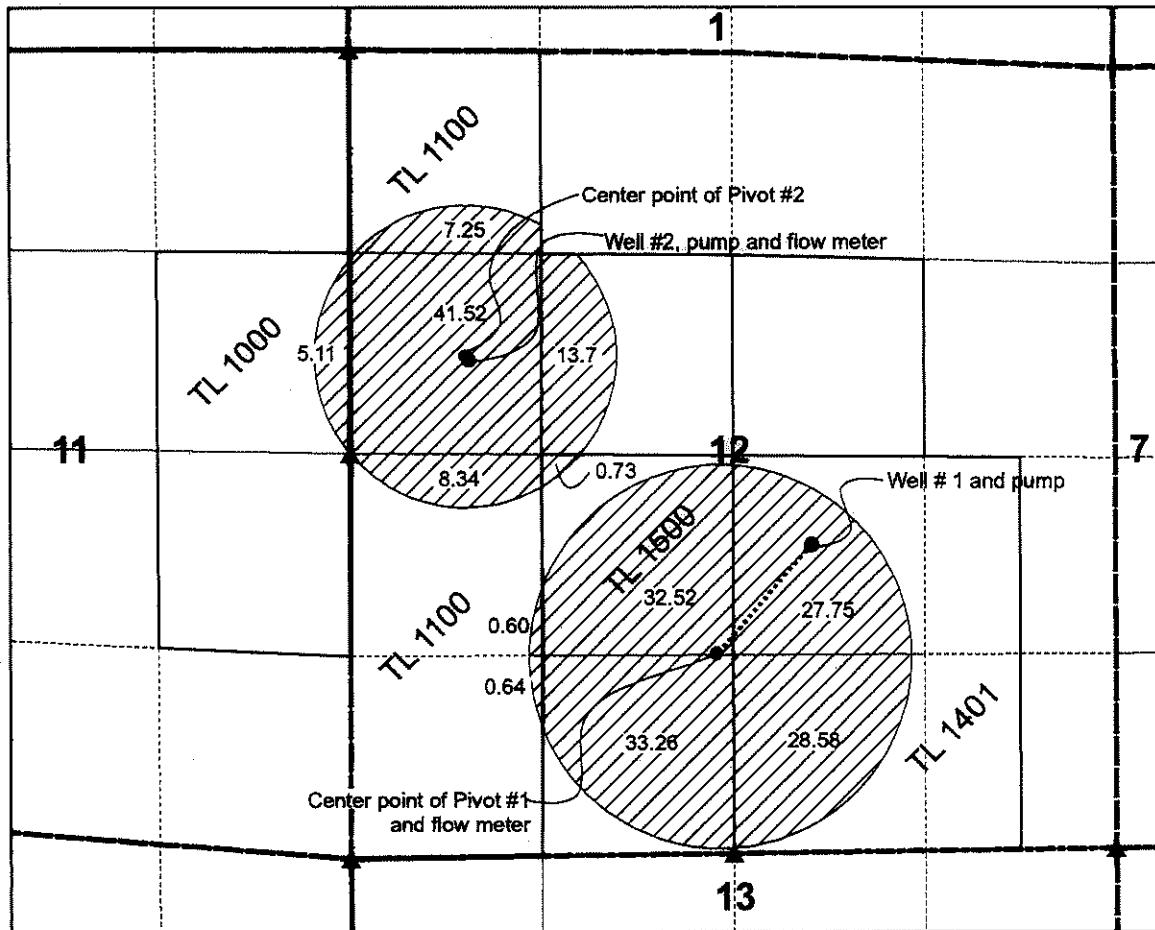

POA Well #1 is located N 14° 8' 5" E 2184.34 ft From
S ¼ Cor. Sec 12, T 27 S, R 22 E, WM. Found Brass Cap

POA Well #2 is located N 28° 9' 26" W 3845.62 ft From
S ¼ Cor. Sec 12, T 27 S, R 22 E, WM. Found Brass Cap


Legend

-  Area of application of water
-  Pipe Line
-  Brass Cap Section Corners



1 inch = 1,320 feet

Note: There is a water
meter at each pivot center

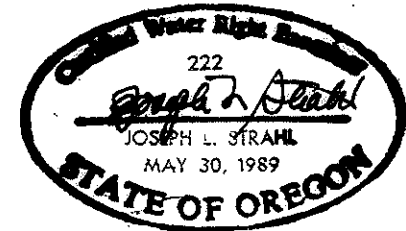

Note: This map is not intended
to provide legal dimensions or
locations of property ownership
lines.

RECEIVED

DEC 30 2019

OWRD