


# Meduri Farms - Claim of Beneficial Use Transfer T-11316

Township 10S, Range 2W, W.M.

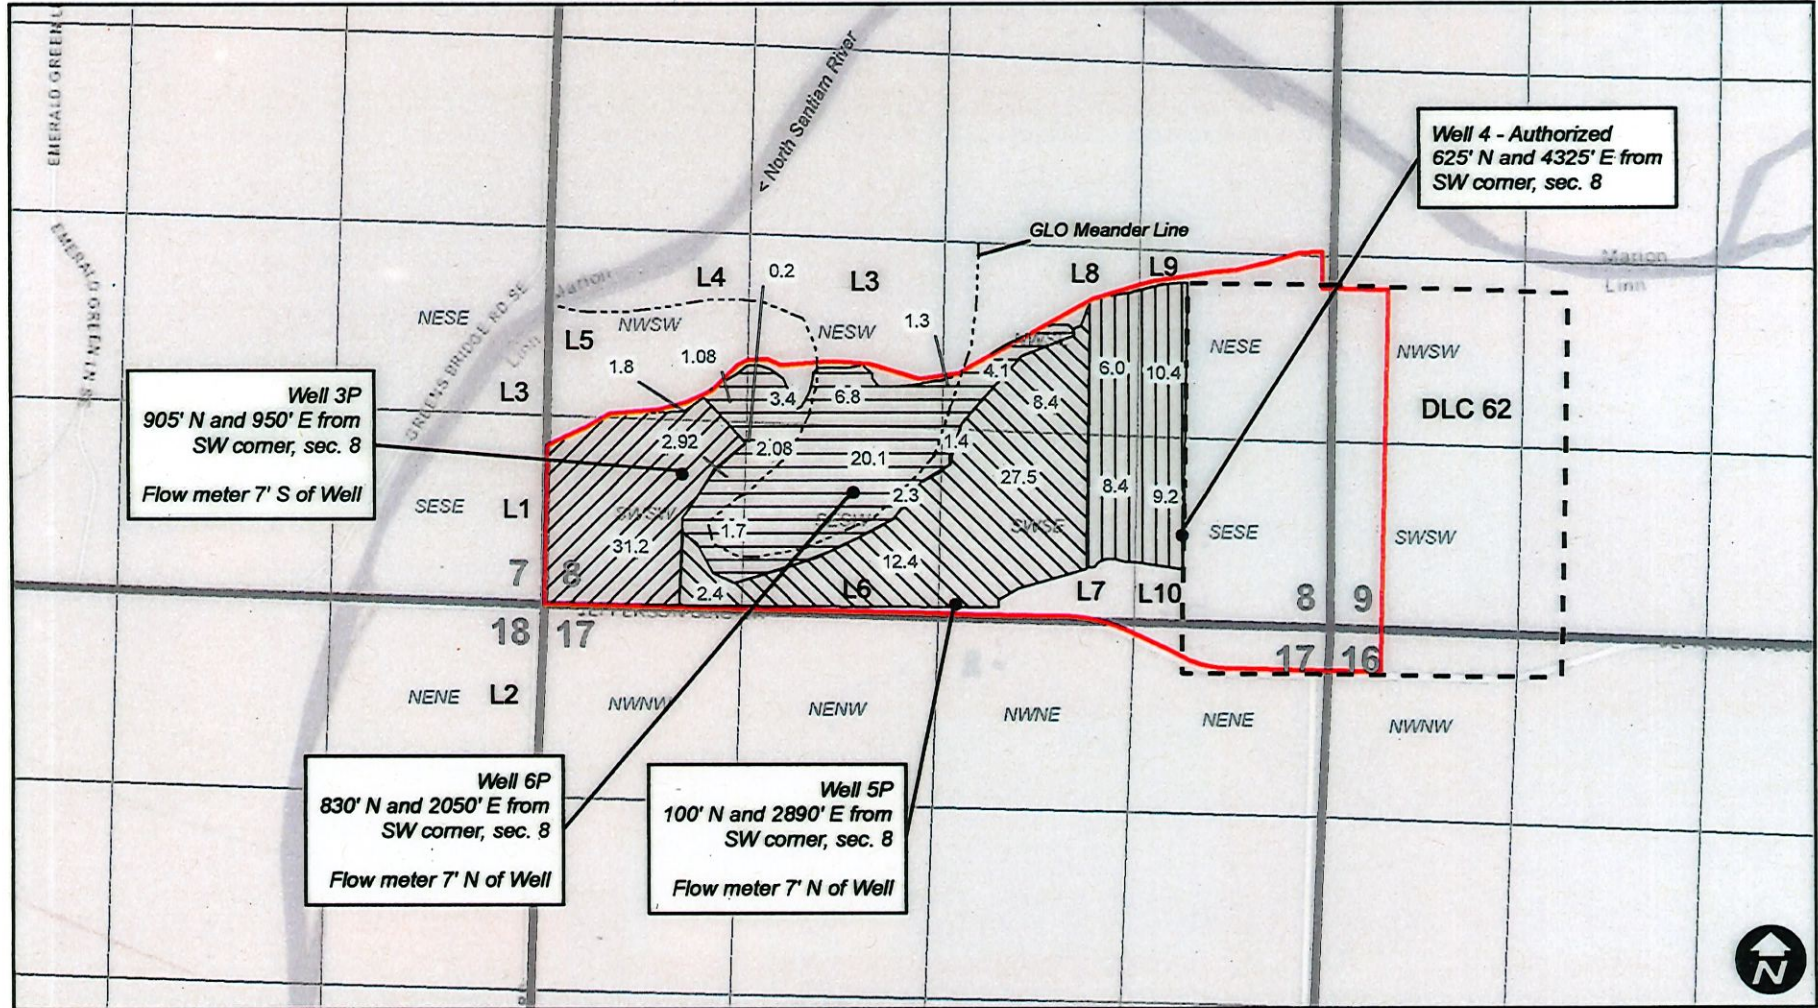


**Well 3P**  
905' N and 950' E from  
SW corner, sec. 8  
Flow meter 7' S of Well

**Well 4 - Authorized**  
625' N and 4325' E from  
SW corner, sec. 8

**Well 6P**  
830' N and 2050' E from  
SW corner, sec. 8  
Flow meter 7' N of Well

**Well 5P**  
100' N and 2890' E from  
SW corner, sec. 8  
Flow meter 7' N of Well

This map is not intended to provide legal dimensions or locations of property ownership lines.

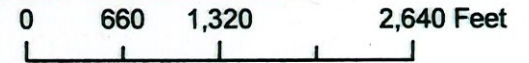

## Legend

- T-11316 (Well 3P) Taxlot 100
- T-11316 (Well 5P) DLC
- T-11316 (Well 6P)
- T-11316 (Well 4) Pending Reversion for APOA, Well 8



EXPIRES: 12-31-2024

RECEIVED  
SEP 05 2013  
OWRD