


RECEIVED
JUN 1 1983
WATER RESOURCES DEPT.
SALEM, OREGON

T.3S.R.12E.W.M.

T-5275

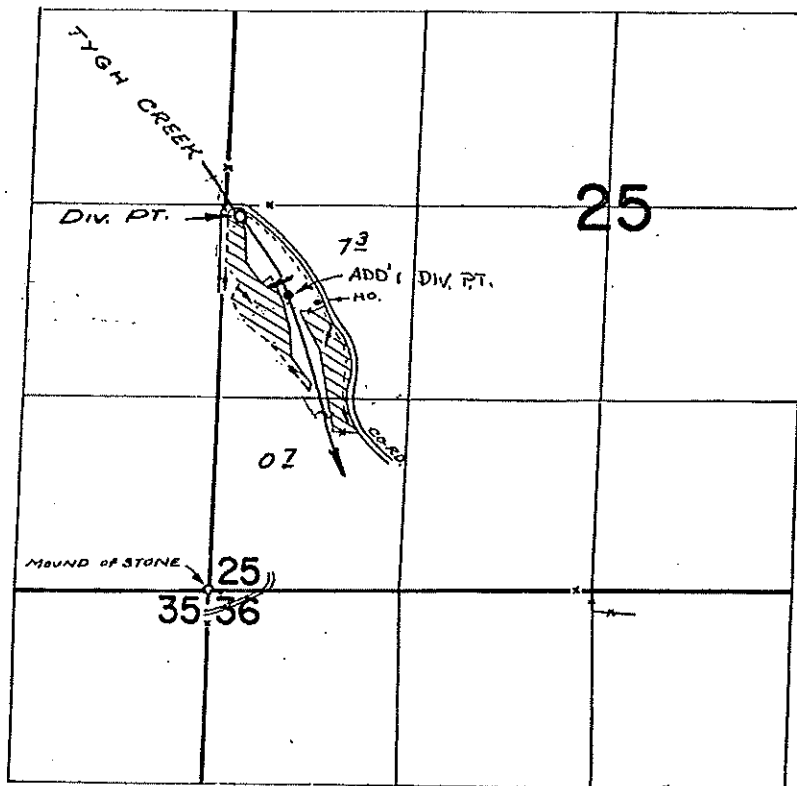

DIV. PT. LOC: 610' S. & 450' E. FROM W 1/4 COR. SEC. 25

FINAL PROOF SURVEY
UNDER

~~TRANSFER NO. R-107~~

Application No. Permit No.

IN NAME OF

JIMOBENE

ROSSELL

Surveyed Oct. 19, 1988, by L. L. Church