



Section 12, T6S, R4W, W.M.,
Polk County, Oregon

Application S-88577, Permit S-55151
CLAIM OF BENEFICIAL USE MAP
Lone Star Road, LLC

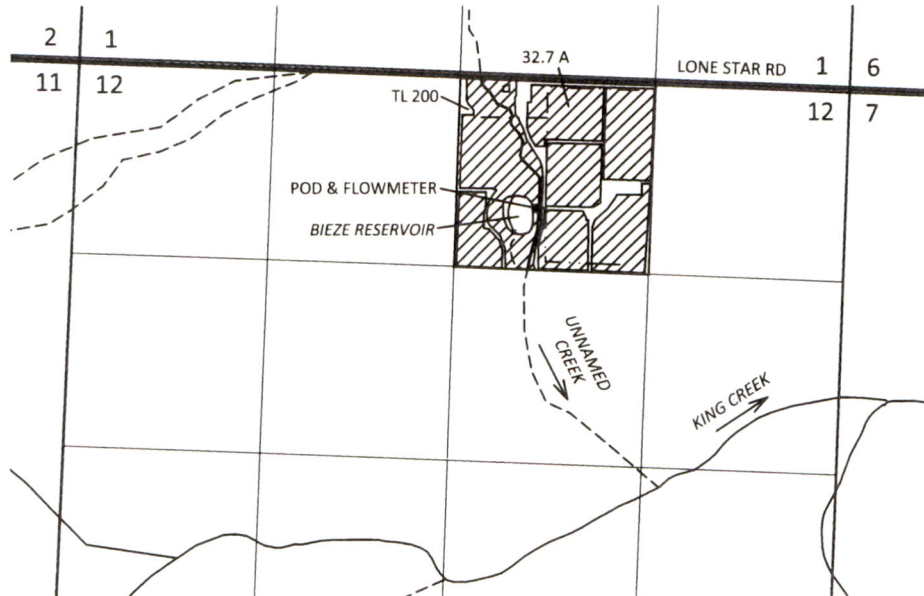

POD LOCATION: 810 FT S AND 2130 FT W FROM NE CORNER OF
SECTION 12, T6S, R4W, W.M.

RECEIVED
NOV 03 2022
OWRD

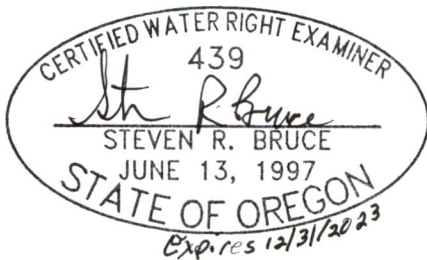

EXPLANATION



PLACE OF USE - IRRIGATION
32.7 ACRES



POINT OF DIVERSION (POD) & FLOWMETER



3" PIPELINE

NOTE:

THE UNNAMED CREEK DOES NOT CONNECT TO THE
RESERVOIR AND IS LOCATED APPROXIMATELY 50 FEET EAST
OF THE RESERVOIR BANK.

Site Inspection Conducted
September 13, 2022



SCALE



1 INCH = 1320 FEET

October 12, 2022

This map is not intended to provide legal
dimensions or locations of property
ownership lines

Figure 1

SKOOKUM
WATER ASSOCIATES INC

1626 VICTORIAN WAY
EUGENE, OR 97401
(503) 319-8926