



- POD "ON"
- POD "REMAINING"
- ⊙ POD "OFF"
- Ditch
- Creek
- POU IR C-25324 1883 "ON"
- POU IR C-25608 1884 "ON"
- POU IR C-25608 1884 "REMAINING"
- POU IR C-25608 1884 "OFF"
- POU IR C-25324 1883 "OFF"
- Section
- Quarter Quarter
- Tax Lot

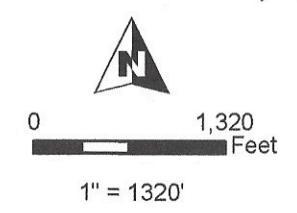

**T11S R30E, WM,
GRANT COUNTY, OR**



RENEWAL DATE 12/31/2024

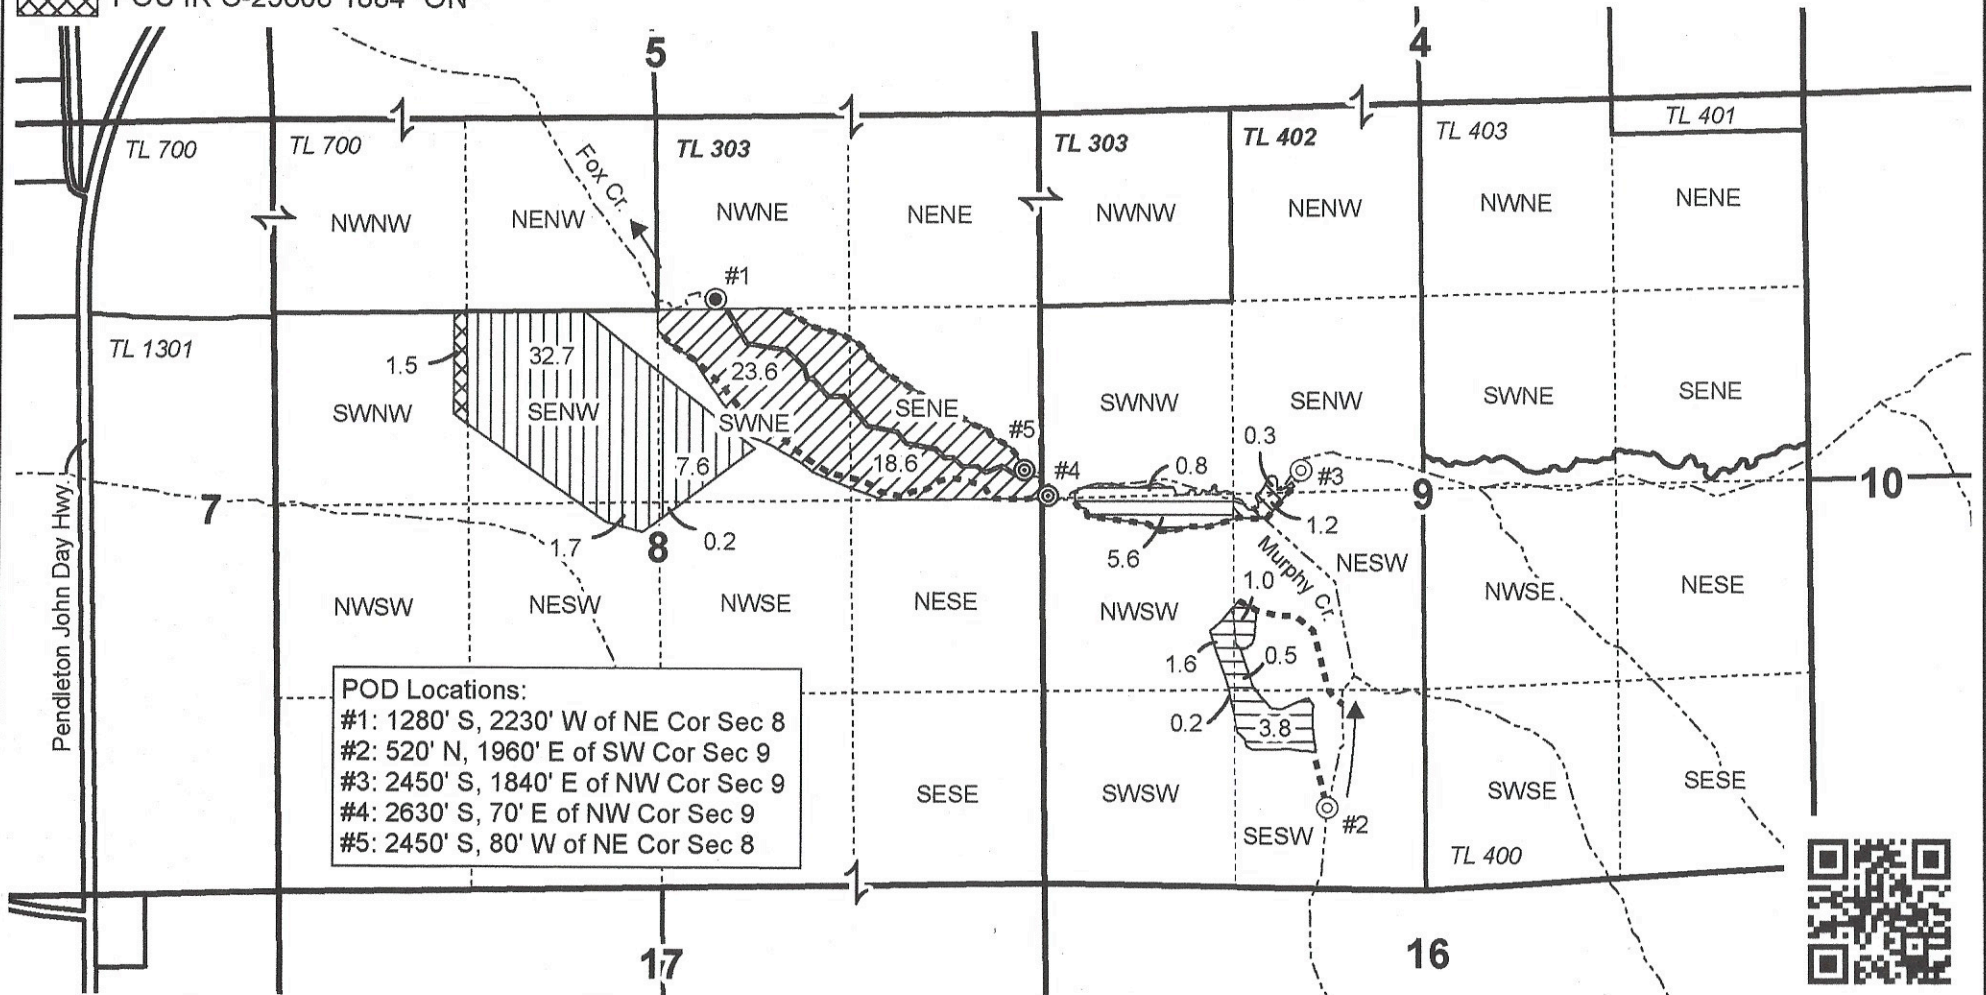

**TRANSFER MAP
MGN, LLC RANCH**

Certificate 25324 & Certificate 25608

Date: 5/25/2023

This map is not intended
to provide legal dimensions
or locations of property
ownership lines.

WATER RIGHT SERVICES, LLC
PO BOX 1830, BEND, OR 97709
WWW.OREGONWATER.US CCB # 197121
johnshort@usa.com 541-389-2837