


Claim of Beneficial Use - ACMPC Oregon 3, LLC

Application S-88398, Permit S-55124

RECEIVED
MAR 17 2023

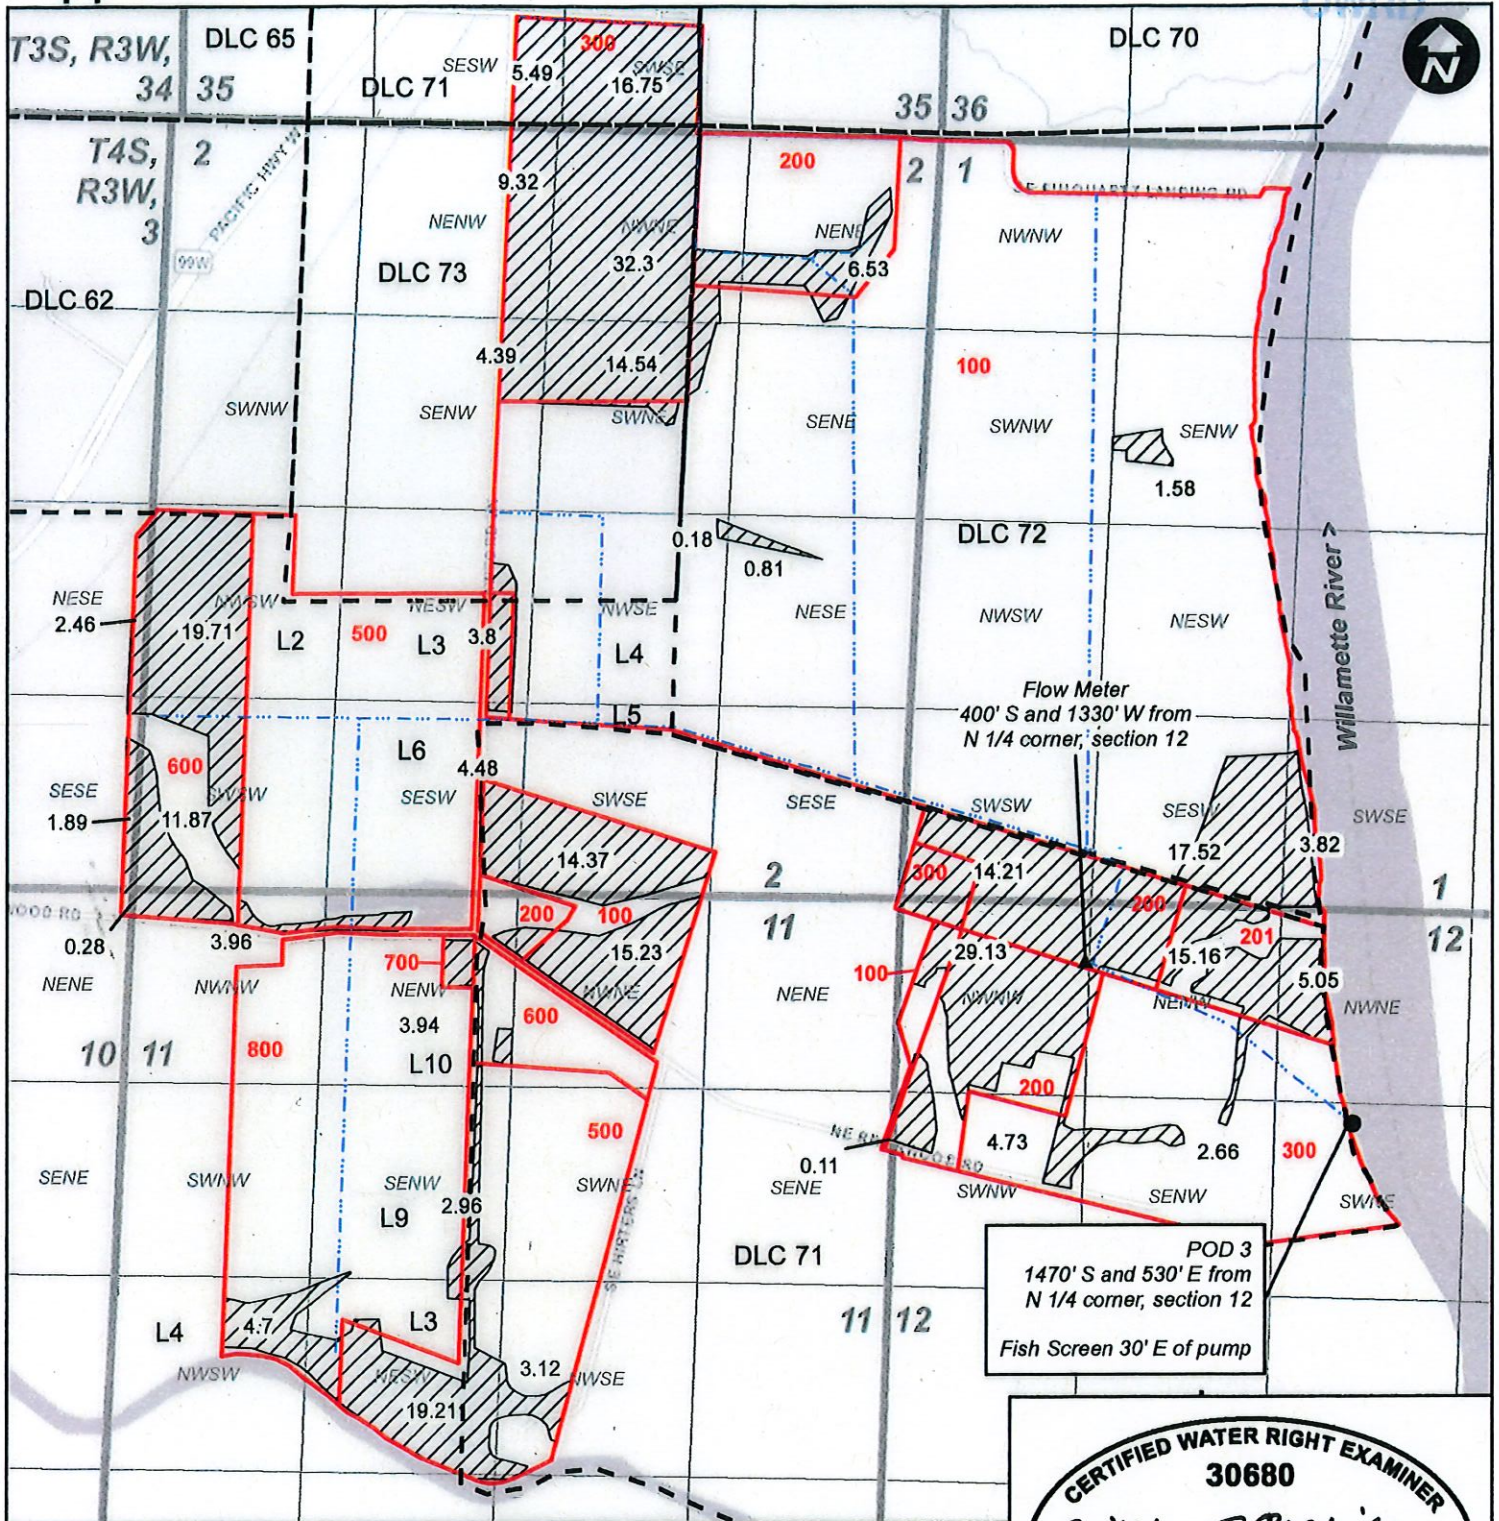

Legend

- POU.
- Taxlots
- Mainline
- DLC

This map is not intended to provide legal dimensions or locations of property ownership lines.

0 660 1,320 2,640 Feet

CERTIFIED WATER RIGHT EXAMINER
30680
William E. McGill
WILLIAM E. MCGILL
MAY 3, 2011
STATE OF OREGON
EXPIRES: 12-31-2024