


Claim of Beneficial Use Permit S-46551, Application S-62429

A Water Right held by David Leff
Coos County

RECEIVED
JUL 03 2023

OWRD

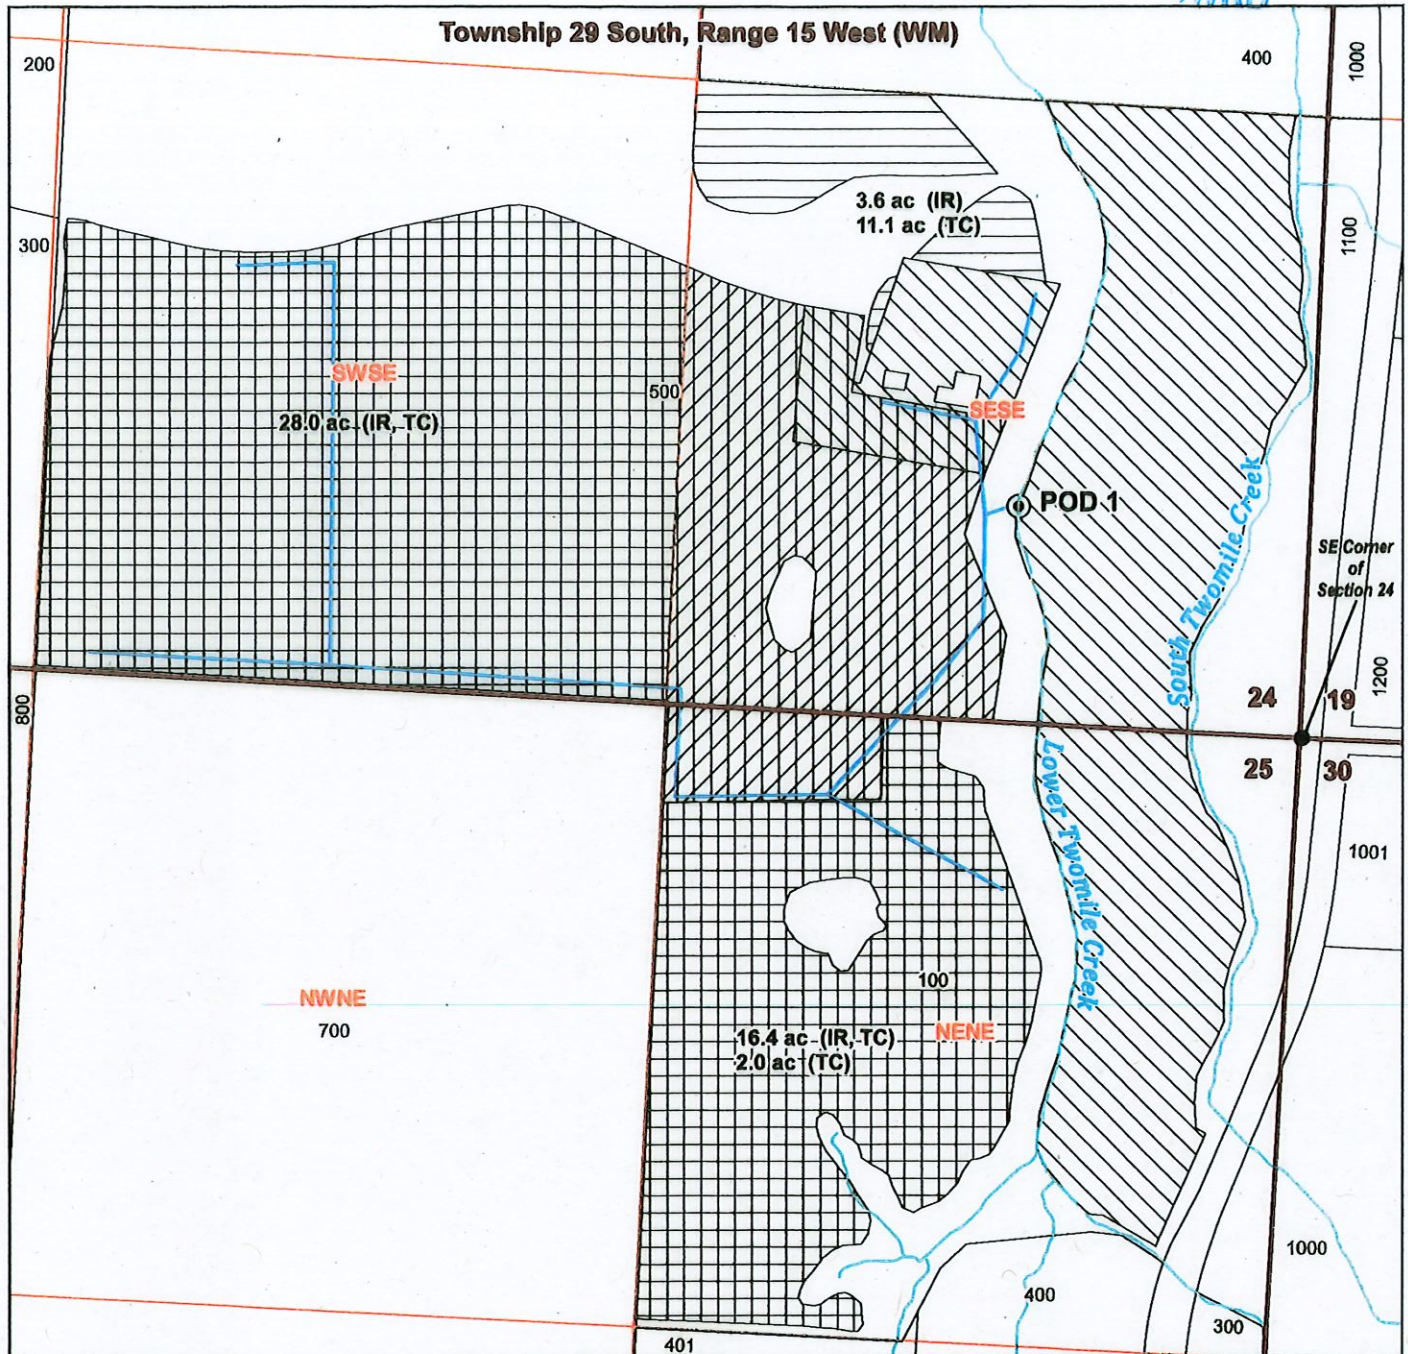

LEGEND

- Point of Diversion (POD)
- ▨ Place of Use (POU), Permit S-46551 (IR)
- ▤ POU, Permit S-46551 (TC)
- ▧ POU, Permit S-46551 (IR, TC)
- ▩ POU, Certificate 50470
- POU, Certificate 21883
- Property Lines
- ~ Streams
- Conveyance Mains


POA Location Description

POD 1
Located 450 feet North and 600 feet West from SE corner of Section 24 (SESE), Township 29 South, Range 15 West, WM



RENEWS: 12-31-2024

CWRE Seal and Signature

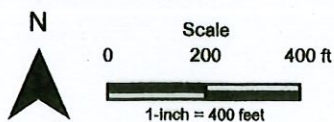

Date: 6/2/2023
Data Sources: BLM, OWRD, USGS, Coos County.
Disclaimer: This map is not intended to provide legal dimensions or property ownership lines.

