

**Final Proof Survey Map
for T-8867 (Meenderinck)**
T3N, R26E, W.M.
Section: 14
Morrow County, Oregon

Legend

- New Well
- Existing Well
- ▲ Flow Meter
- Dairy Use
- Irrigation
- 10 Inch Buried Pipeline
- 6 Inch Buried Pipeline
- .-.- 4 Inch Buried PVC

Well Location



Well 1

Located 2540 feet South and 1520 feet West from the NE corner, section 14 T3N R26E, W.M.

Well 2

Located 747 feet South and 2638 feet West from the NE corner, section 14 T3N R26E, W.M.

Certified Water Rights Examiner Stamp

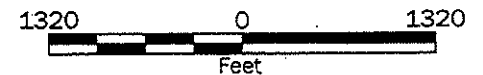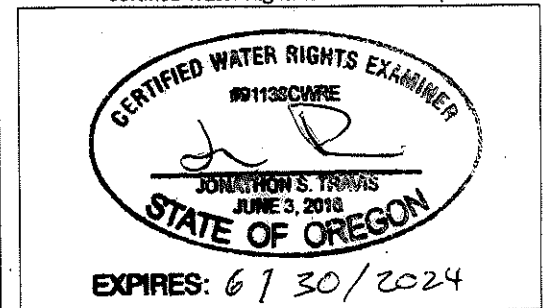

Disclaimer

This map was prepared for the purpose of identifying the location of a water right only and it is not intended to provide legal dimensions or location of property ownership lines.

Map Notes

Date: 06/24/2020

Data Sources: ESRI

Prepared By: GeoEngineers

