


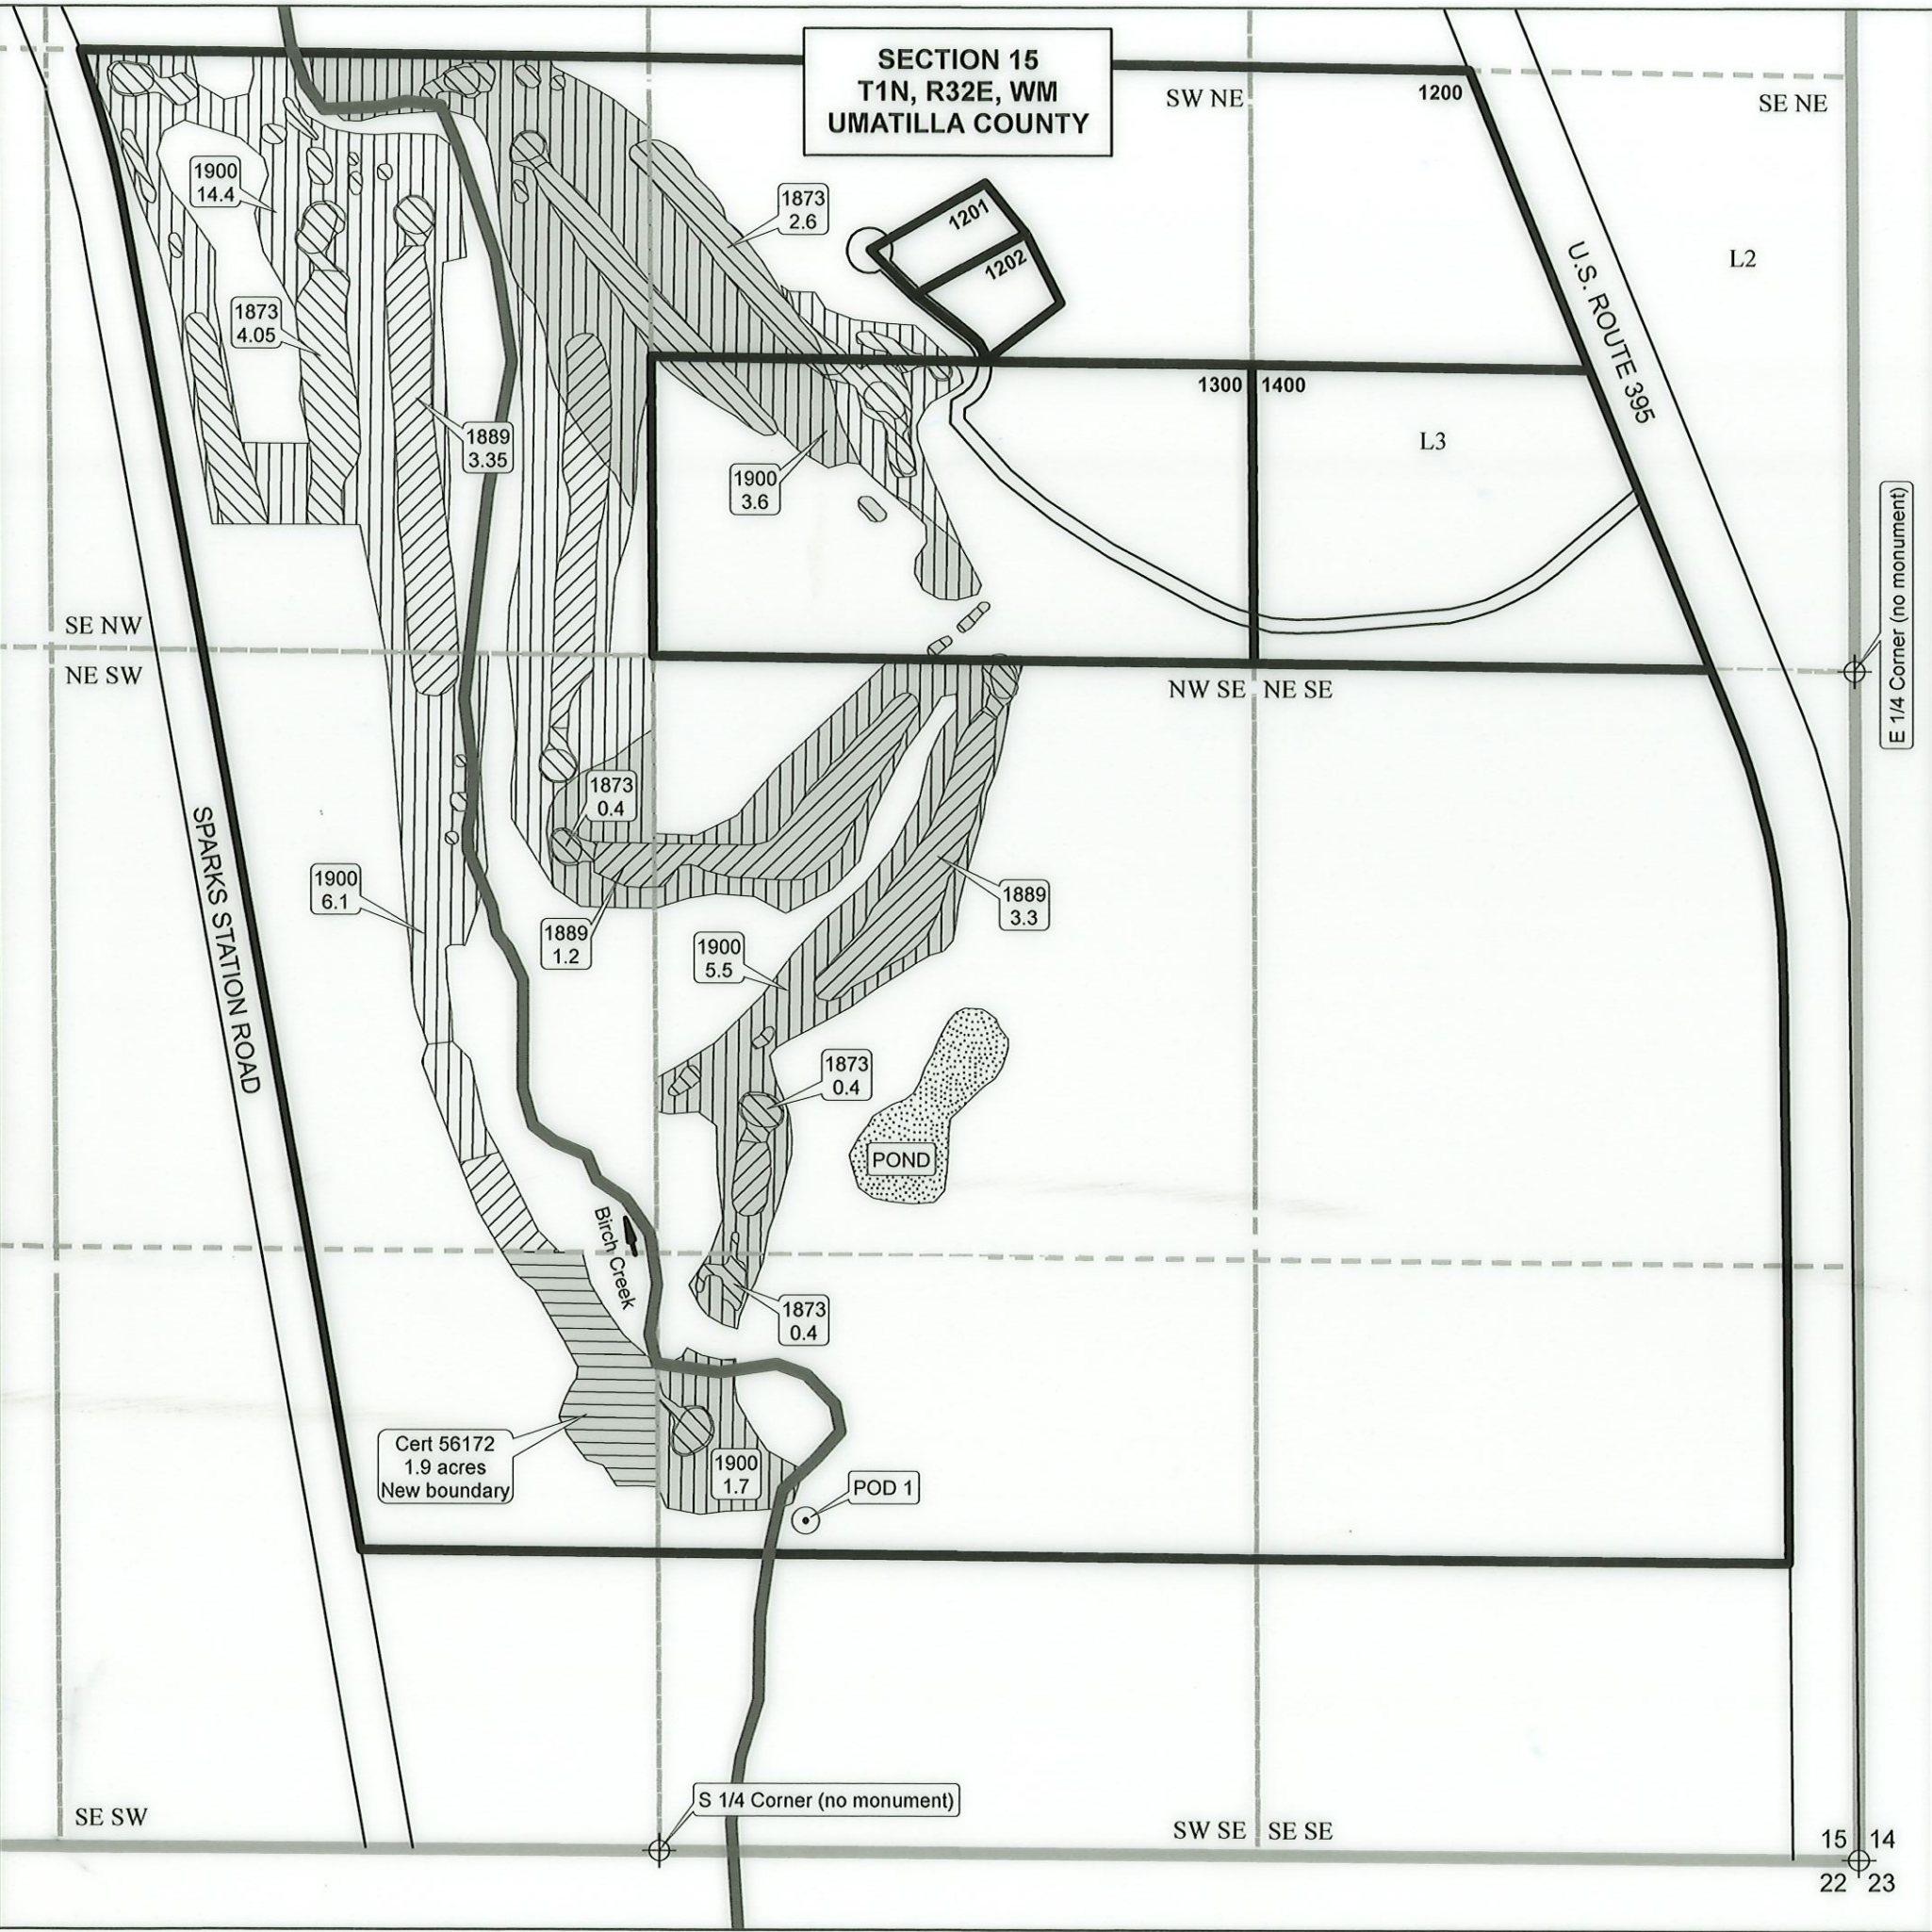

LEGEND

⊙ **Point of Diversion**


POD 1 located 710 feet N and 2340 feet W from SE Corner of Section 15.
Fish screen and flowmeter installed at same location.

POD 2 not developed.


 Place of Use

-  Cert 56171 - 1873 Priority
3.99 ac supplemental to Cert 57558
3.86 ac supplemental to Cert 84481
-  Cert 56171 - 1889 Priority
3.81 ac supplemental to Cert 57558
4.04 ac supplemental to Cert 84481
-  Cert 56171 - 1900 Priority
15.5 ac supplemental to Cert 57558
15.8 ac supplemental to Cert 84481
-  Cert 56172 - 1894 Priority (change boundary shape only)
1.9 ac supplemental to Cert 84481
-  Cert 57558 - Primary Groundwater Right
-  Cert 84481 - Primary Groundwater Right

COBU MAP # 2031

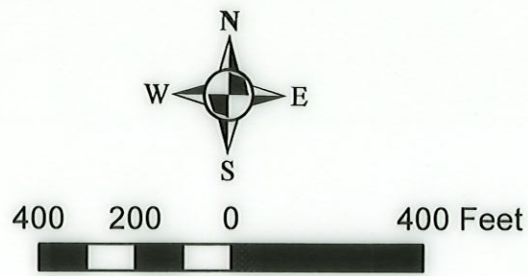

DISCLAIMER
The purpose of this map is to identify the location of a water right. It is not intended to provide information regarding the location of property ownership lines.

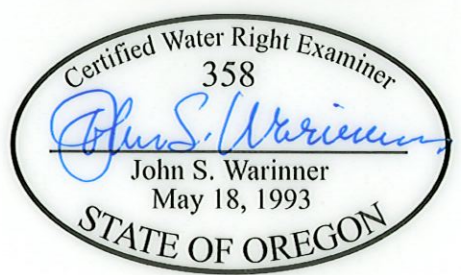

CLAIM OF BENEFICIAL USE MAP
Transfer 10311
Place of Use and Point of Diversion

in the name of
CTUIR

21 JUN 2022