


RECEIVED

MAY 18 2020

OWRD


T.6S. R.2W. Sec. 34 & 35, T.7S. R.2W. Sec. 2 & 3, W.M.

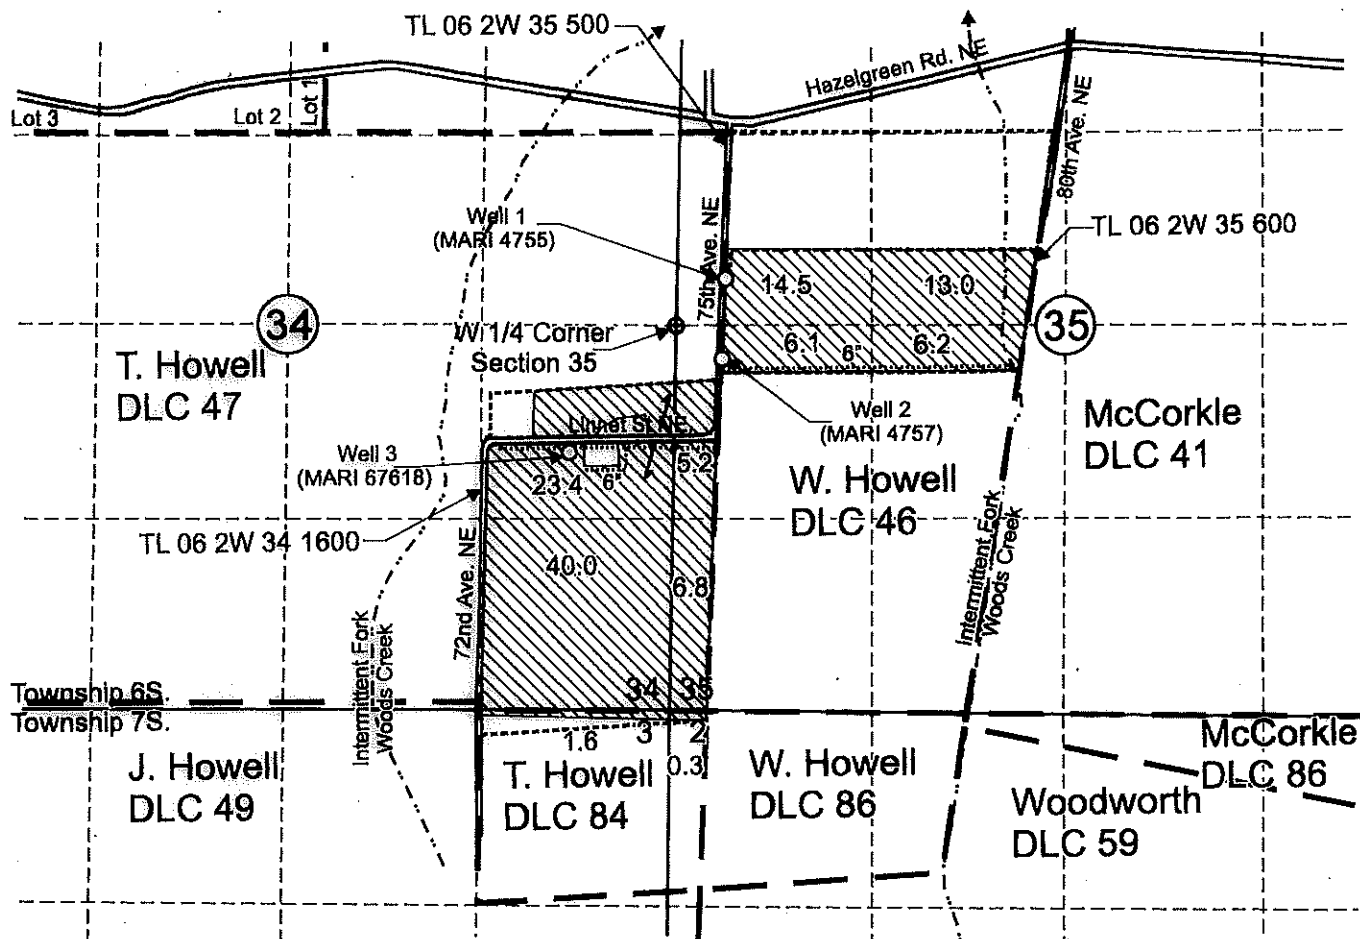

Well 1 (MARI 4755) is located 320 feet north and 310 feet east from the W 1/4 corner, Section 35.

Well 2 (MARI 4757) is located 240 feet south and 290 feet east from the W 1/4 corner, Section 35.


Well 3 (MARI 67618 / L-127220) is located 1,750 feet north and 690 feet west from the SE corner, Section 34.

 Area (117.1 Acres) irrigated under T-12445.

----- Tax lot boundary

— — — — — Donation Land Claim boundary

..... Irrigation mainline

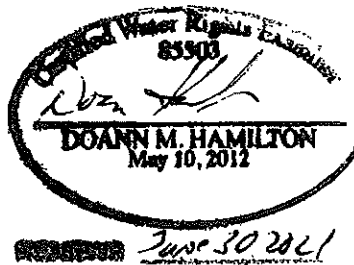

This map was prepared for the purpose of identifying the location of a water right only and is not intended to provide legal dimensions or location of property ownership lines.

Scale: 1" = 1,320'



0 1,320 Feet

Pacific Hydro-Geology Inc.

Claim of Beneficial Use Map
T-12445

Jensen Family LLC
T.6S. R.2W. Sec. 34 & 36,
T.7S. R.2W. Sec. 2 & 3, W.M.

04/2020