


- POD
- ▣ Pump & Fishscreen
- Creek
- Pipeline
-  POU IR 1907 Priority
-  POU IR 1917 Priority
- Quarter Quarter
-  Tax Lot

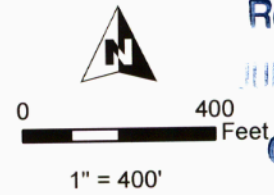


RENEWAL DATE 12/31/2024

**T13S R16E, WM
CROOK COUNTY, OR**



Received
JUN 08 2024
OWRD

POD Location:
1980' S, 630' E of N 1/4 Cor Sec 33

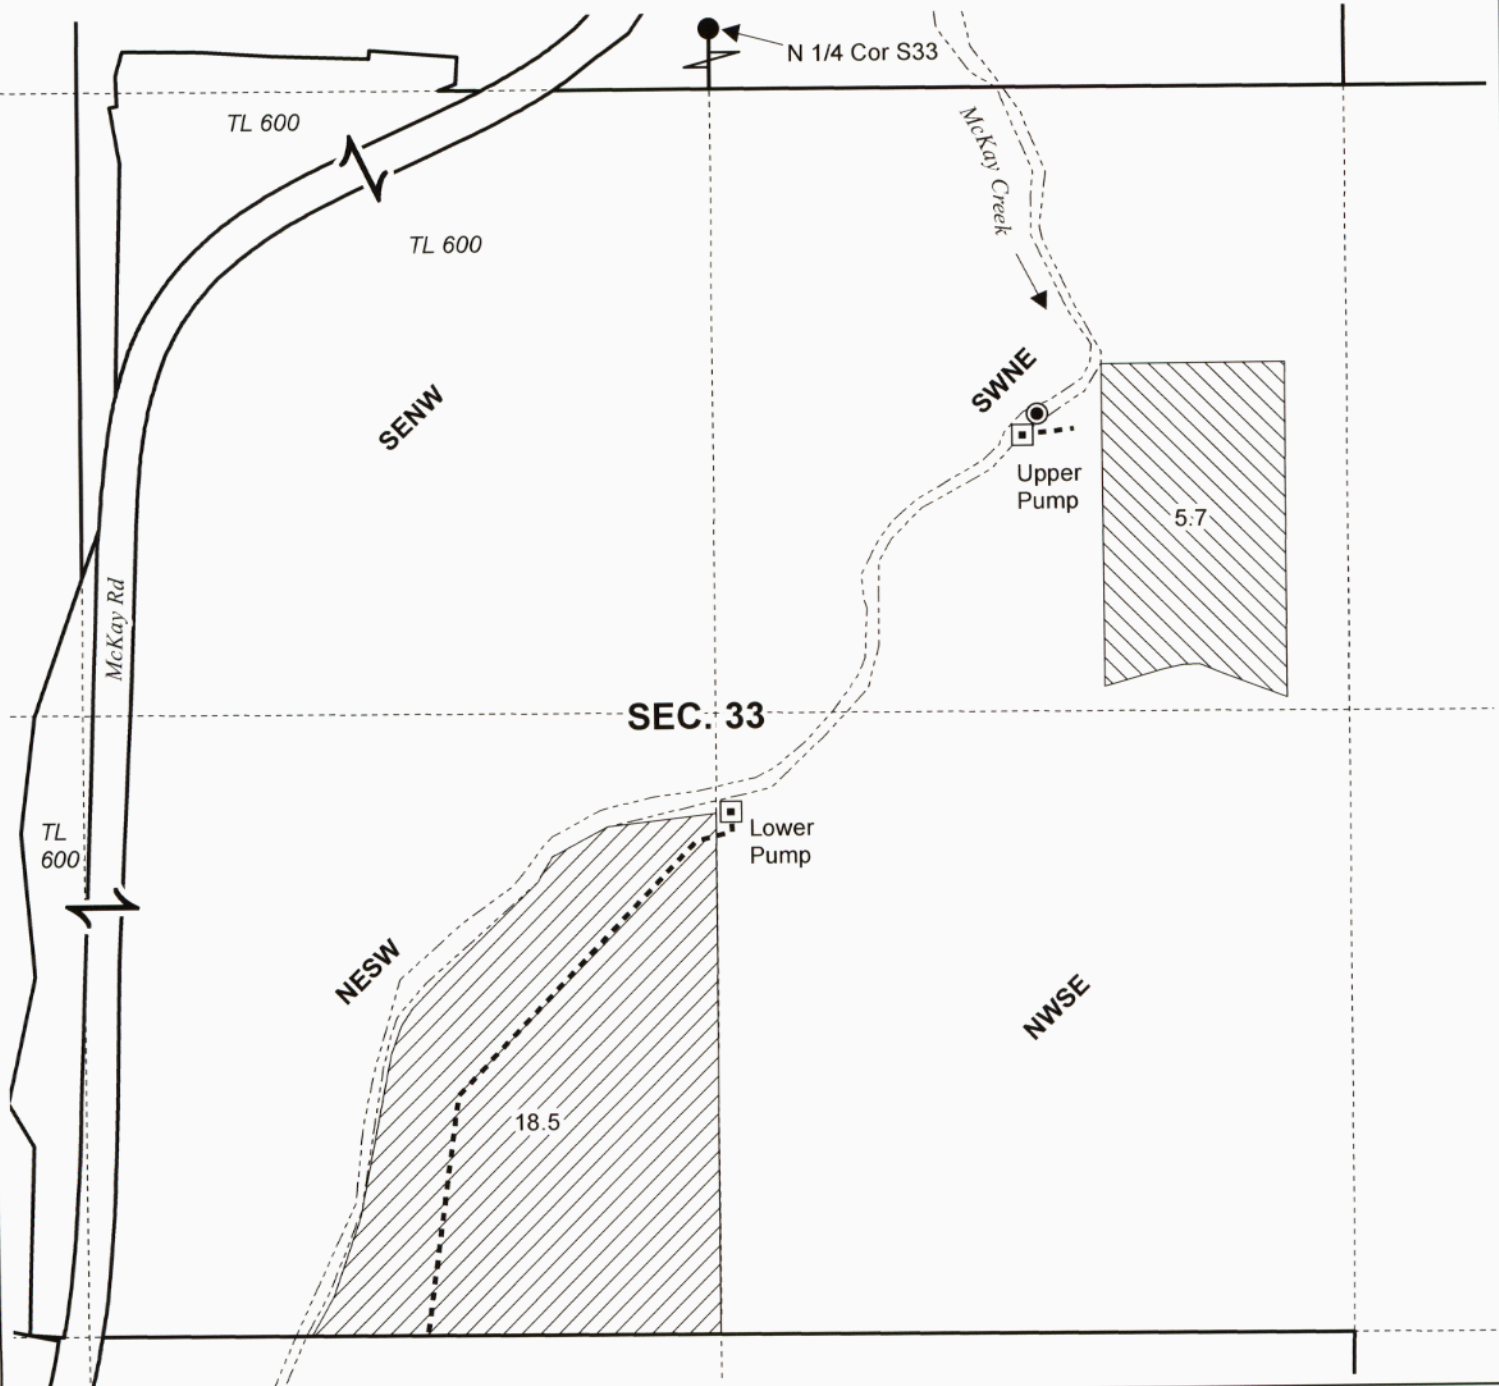

**CLAIM OF BENEFICIAL USE MAP
G&L PROPERTY HOLDINGS, LLC**

This map is not intended
to provide legal dimensions
or locations of property
ownership lines.

WATER RIGHT SERVICES, LLC
PO BOX 1830, BEND, OR 97709
WWW.OREGONWATER.US CCB # 197121
johnshort@usa.com 541-389-2837

Date: 6/26/2024 T-6656 Project #24008