


- POD
- ▣ Pump & Fishscreen
- Creek
- Pipeline
- ▨ POU IR 1907 Priority
- ▨ POU IR 1917 Priority
- Quarter Quarter
- Tax Lot

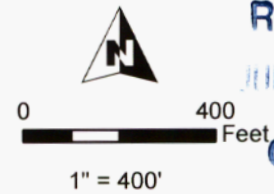

RENEWAL DATE 12/31/2024


T13S R16E, WM CROOK COUNTY, OR



Received
JUL 08 2024

OWRD

POD Location:
1980' S, 630' E of N 1/4 Cor Sec 33

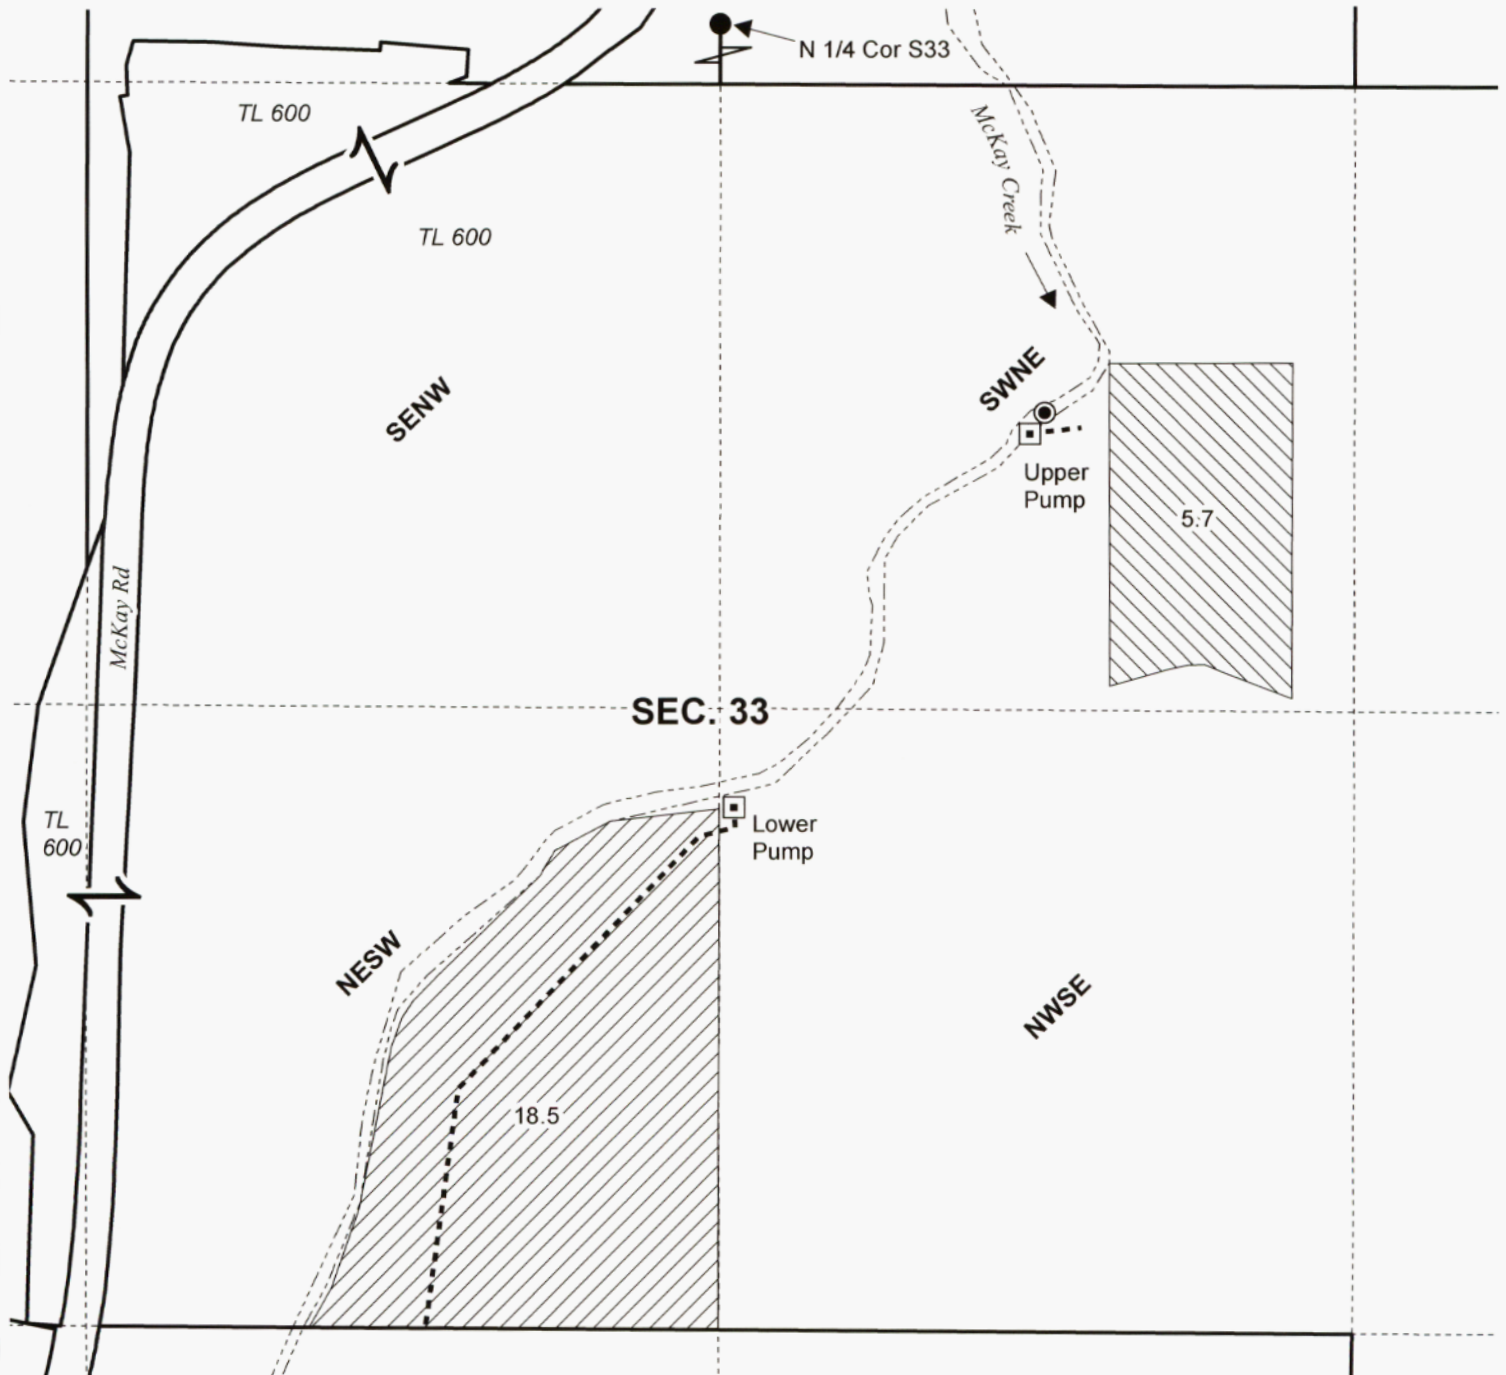

CLAIM OF BENEFICIAL USE MAP G&L PROPERTY HOLDINGS, LLC

Date: 6/26/2024 T-6656 Project #24008

This map is not intended
to provide legal dimensions
or locations of property
ownership lines.

WATER RIGHT SERVICES, LLC
PO BOX 1830, BEND, OR 97709
WWW.OREGONWATER.US CCB # 197121
johnshort@usa.com 541-389-2837