


Claim of Beneficial Use
Permit R-11801, Application 72542
A Water Right in the Name of Dandrew Wine, LLC
Yamhill County, Oregon
Township 2 and 3 South, Range 4 West (W.M.)

RECEIVED

JUN 10 2021

OWRD

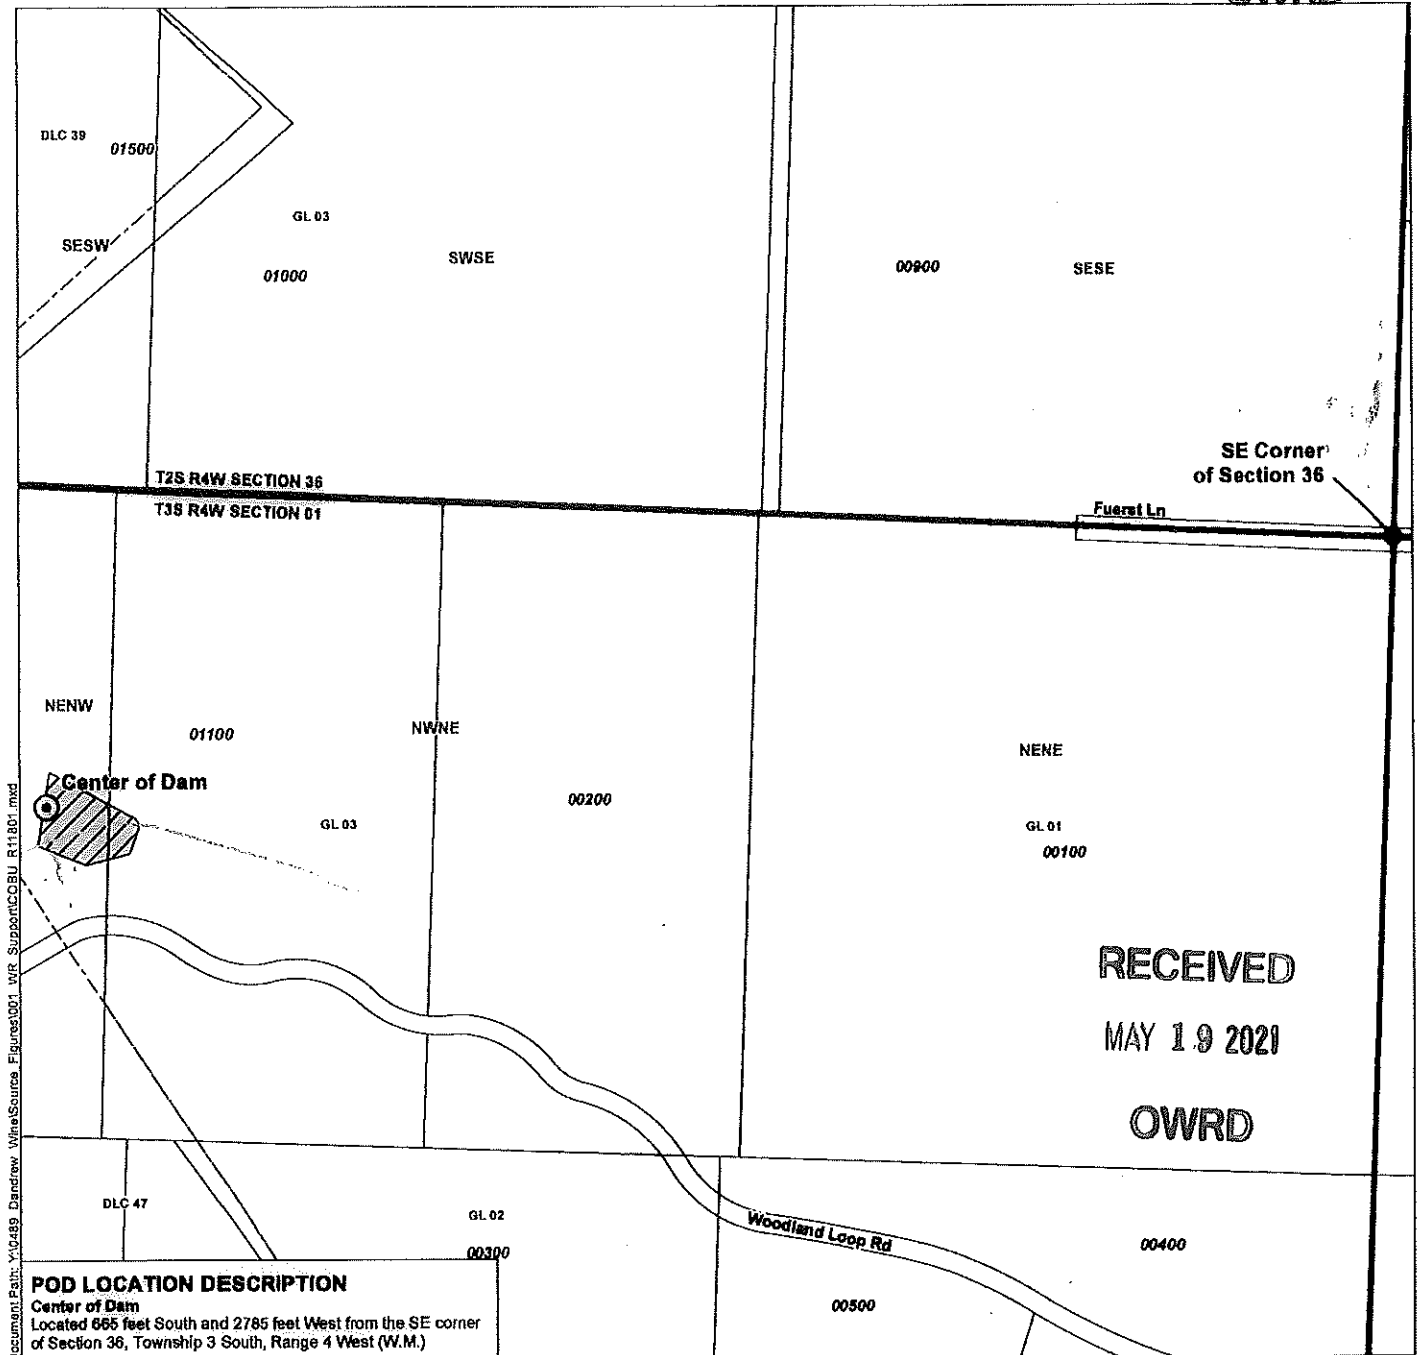

RECEIVED


MAY 19 2021

OWRD

LEGEND

- ⊙ Point of Diversion (POD)
- ▨ Place of Use (POU)
- Donation Land Claim (DLC)
- Government Lot (GL)
- ⊕ Tax Lot
- Watercourse

Certified Water Rights Examiner Stamp

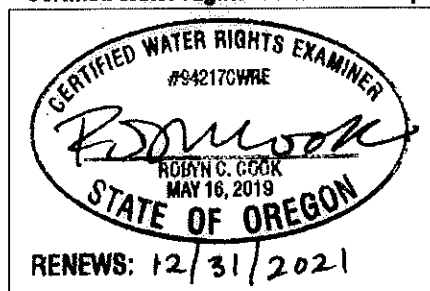

DISCLAIMER

This map was prepared for the purpose of identifying the location of a water right only and it is not intended to provide legal dimensions or location of property ownership lines.

MAP NOTES

Date: April 26, 2021

Data Sources: OGIC, Yamhill Co., BLM, USGS

