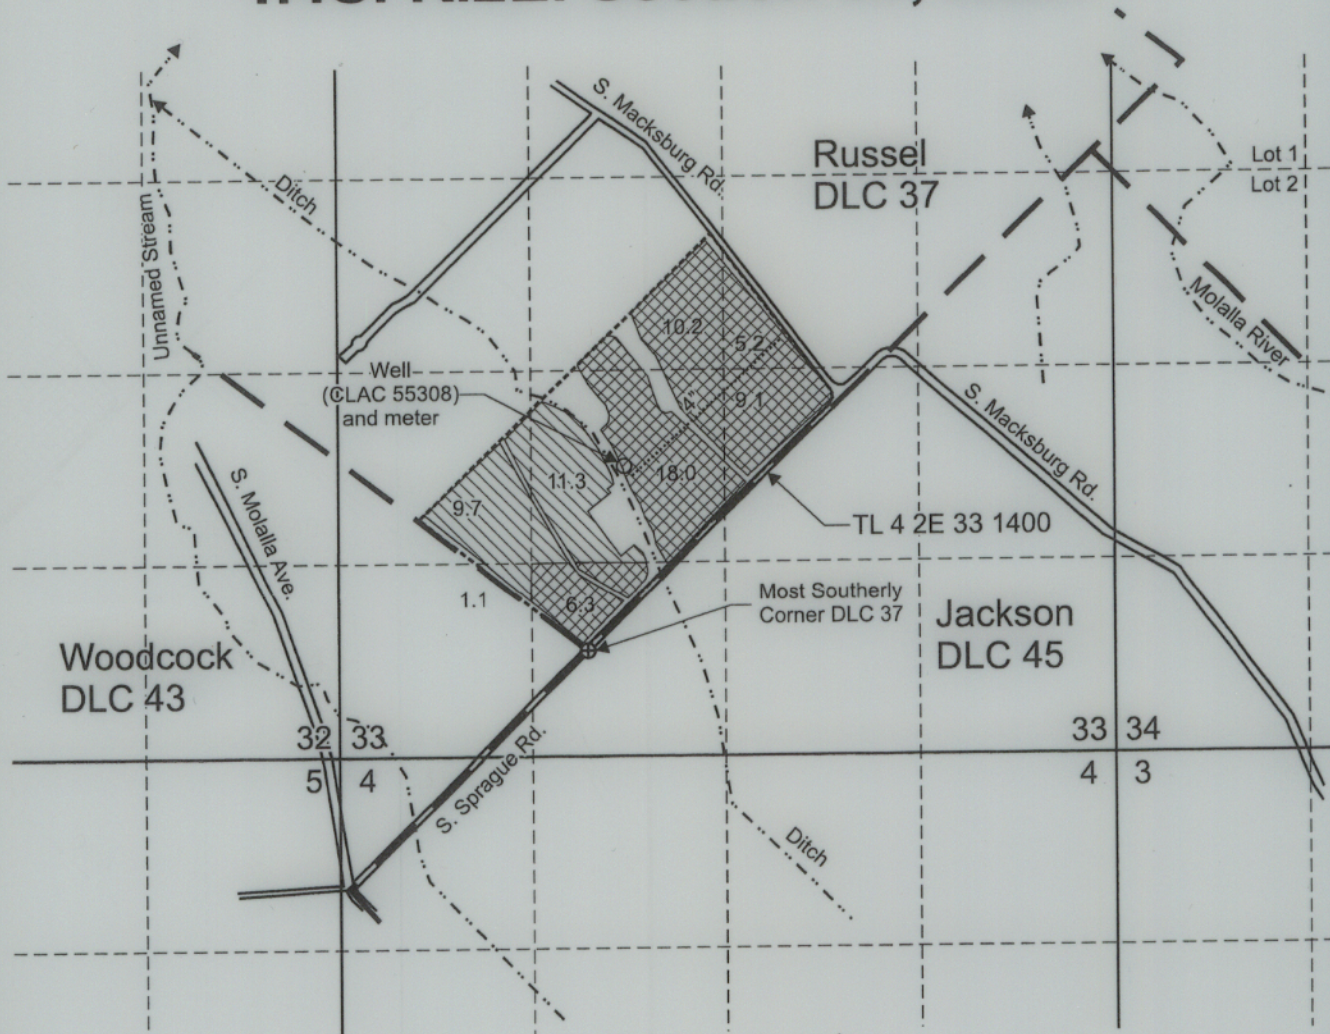

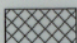


# T.4S. R.2E. Section 33, W.M.



Well (CLAC 55308) is located 1,255 feet north and 250 feet east from the most southerly corner, DLC 37.

-  Area (22.1 Acres) of primary irrigation under Application G-15206, Permit G-15592.
-  Area (48.8 Acres) of supplemental irrigation under Application G-15206, Permit G-15592, primary Certificate 7609.
- Tax lot boundary
- — — — — Donation Land Claim boundary
- ..... Water main line

Scale: 1" = 1,320'



Received  
AUG 12 2024

OWRD



This map was prepared for the purpose of identifying the location of a water right only and is not intended to provide legal dimensions or location of property ownership lines.

Claim of Beneficial Use Map  
Application G-15206, Permit G-15592

John and Monica Man  
T.4S. R.2E. Section 33, W.M.

08/2024

Pacific Hydro-Geology Inc.