


- Well & Meter
- Cistern
- Buried Pipeline
- ▨ POU IR
- Township
- Section
- Quarter Quarter
- Tax Lot

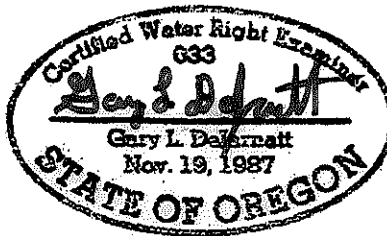

RENEWAL DATE 12/31/2019




T16S R14E, WM, CROOK COUNTY, OREGON




Well (CROO 3243) Location:
1,230' S, 300' E of NW Cor Sec 3

DETAIL
0 400 Feet
1" = 400'

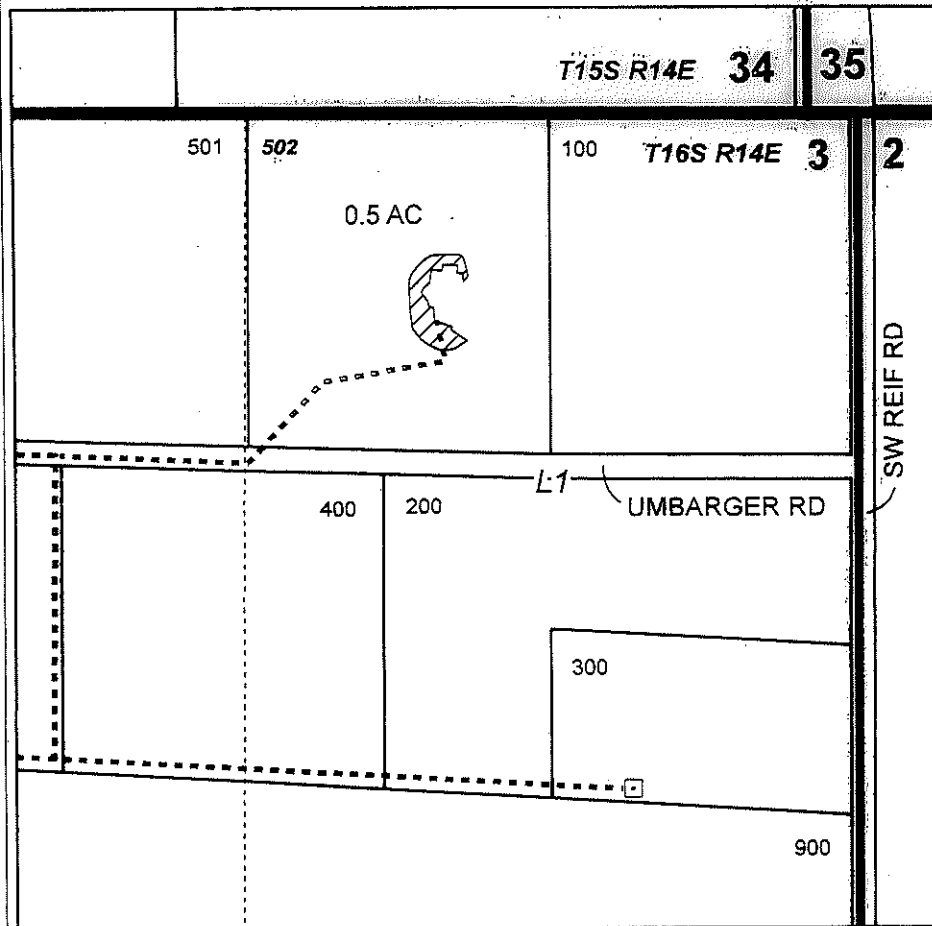

OVERVIEW
0 1,320 Feet
1" = 1,320'

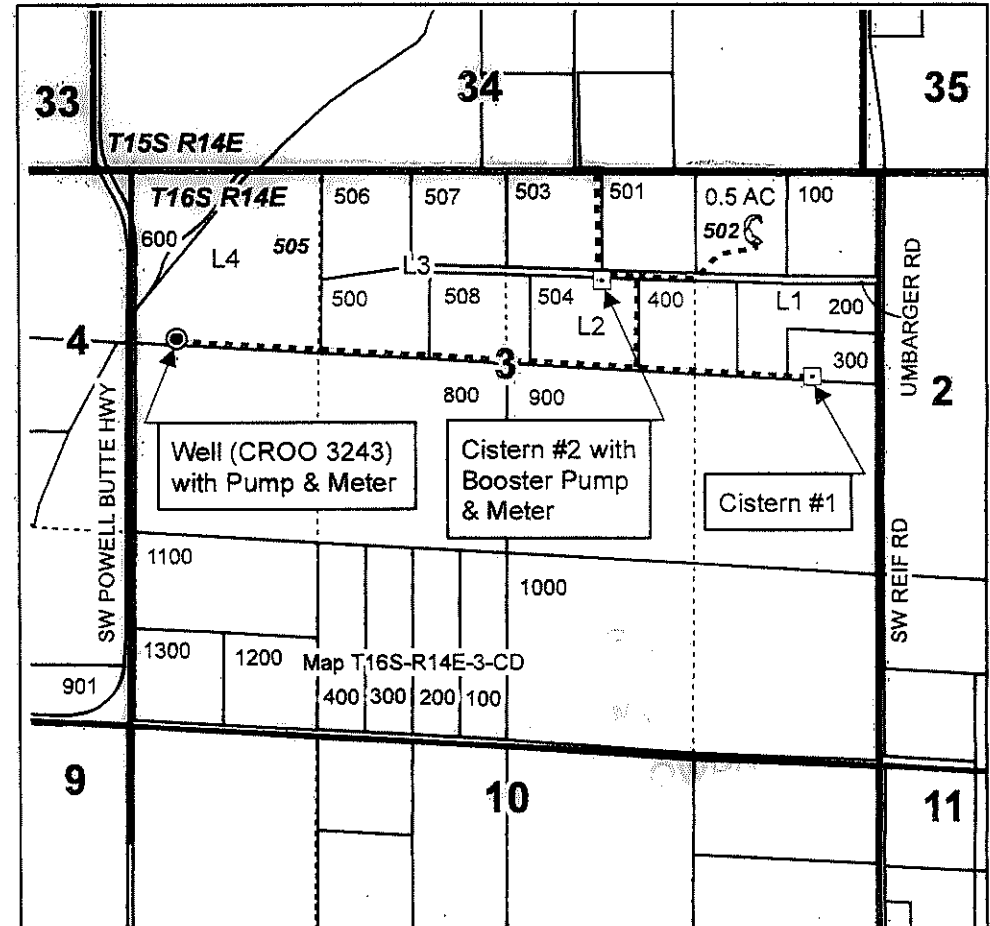

CLAIM OF BENEFICIAL USE MAP
Garry and Kathryn Likens

NOTE: THIS MAP IS NOT INTENDED TO
PROVIDE LEGAL DIMENSIONS OR LOCATIONS
OF PROPERTY OWNERSHIP LINES.

WATER RIGHT SERVICES, LLC
PO BOX 1830, BEND, OR 97709
CCB# 197121 www.oregonwater.us
541-389-2837 JOHNSHORT@USA.COM

AP G-16483

PERMIT G-17907

JOB #18063

Date: 2/12/2019