


T2S, R3W

SESW

Sec. 11
SWSE

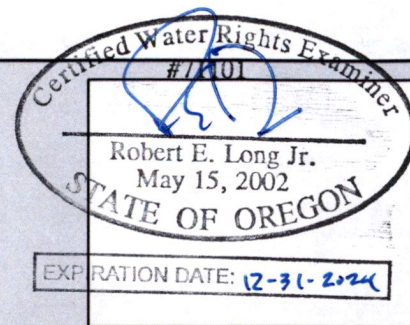

Graver Creek
NENW
POD 1,
790 S, 150' W
from N1/4 corner, Sec. 14

TL 905

NWNE

TL 900

TL 904

NENE

Existing Place of Use:

1.5 ac in NENW of Sec 14
10.1 ac in NWNE of Sec 14
11.6 ac in Taxlot 900

Proposed Place of Use:

2.2 ac in NENW of Sec 14
9.4 ac in NWNE of Sec 14
3.9 ac in Taxlot 905
7.7 ac in Taxlot 900

Sec. 14

SESW

SWNE

Mc Fee Creek

McFee Pl

CwM-H2O

Complete Water Management

311 B Avenue, Suite P
Lake Oswego, Oregon 97034
(503) 954-1326



Figure 3
Cert. 73636 Water Right
Transfer Map

1	DATE	AUTH	DRAFT
No.	Date	By	Revisions



100 0 100 200 ft
1:4800

Proj#: 2405001
Roselli Transfer

Paola Roselli
32508 SW Laurelview Road
Hillsboro, OR, 97123

- Proposed To Lands
- Proposed From Lands
- Existing POU
- Taxlot Boundaries
- Proposed POD
- Proposed Distribution Lines


RECEIVED

MAR 22 2024

OWRD

14426 -

T.2S. R.3W. W.M.

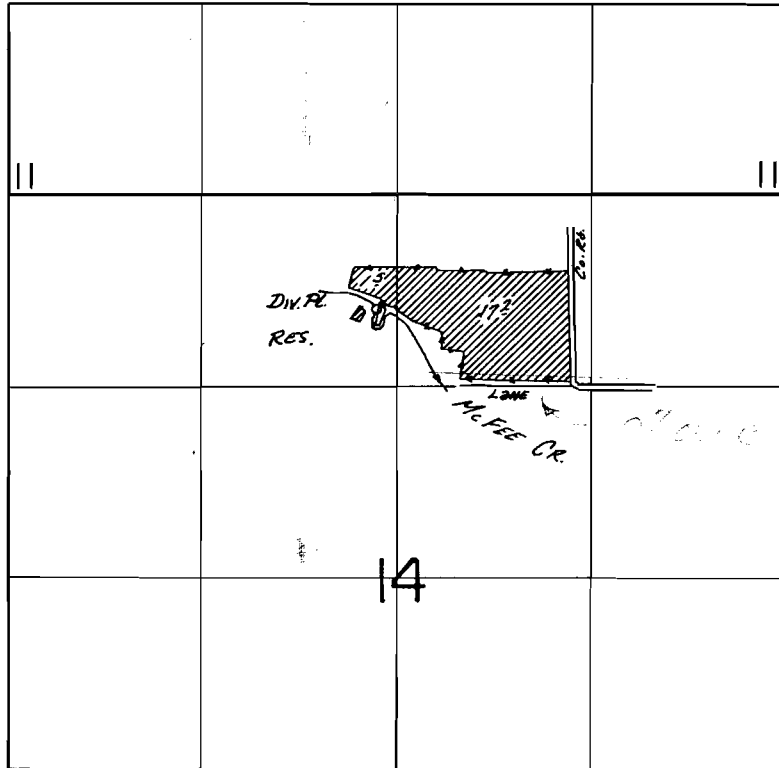

DIV. LOC. 790' S & 150' W; RES. LOC. 840' S & 100' W BOTH FROM N¹/₄ COR SEC 14

FINAL PROOF SURVEY
UNDER

R-47873 R-5686
Application No. 47217 Permit No. 35370
IN NAME OF

FORREST J HORTON

Surveyed Oct 1 1974, by R. G. MUCKEN