


COBU MAP #2110


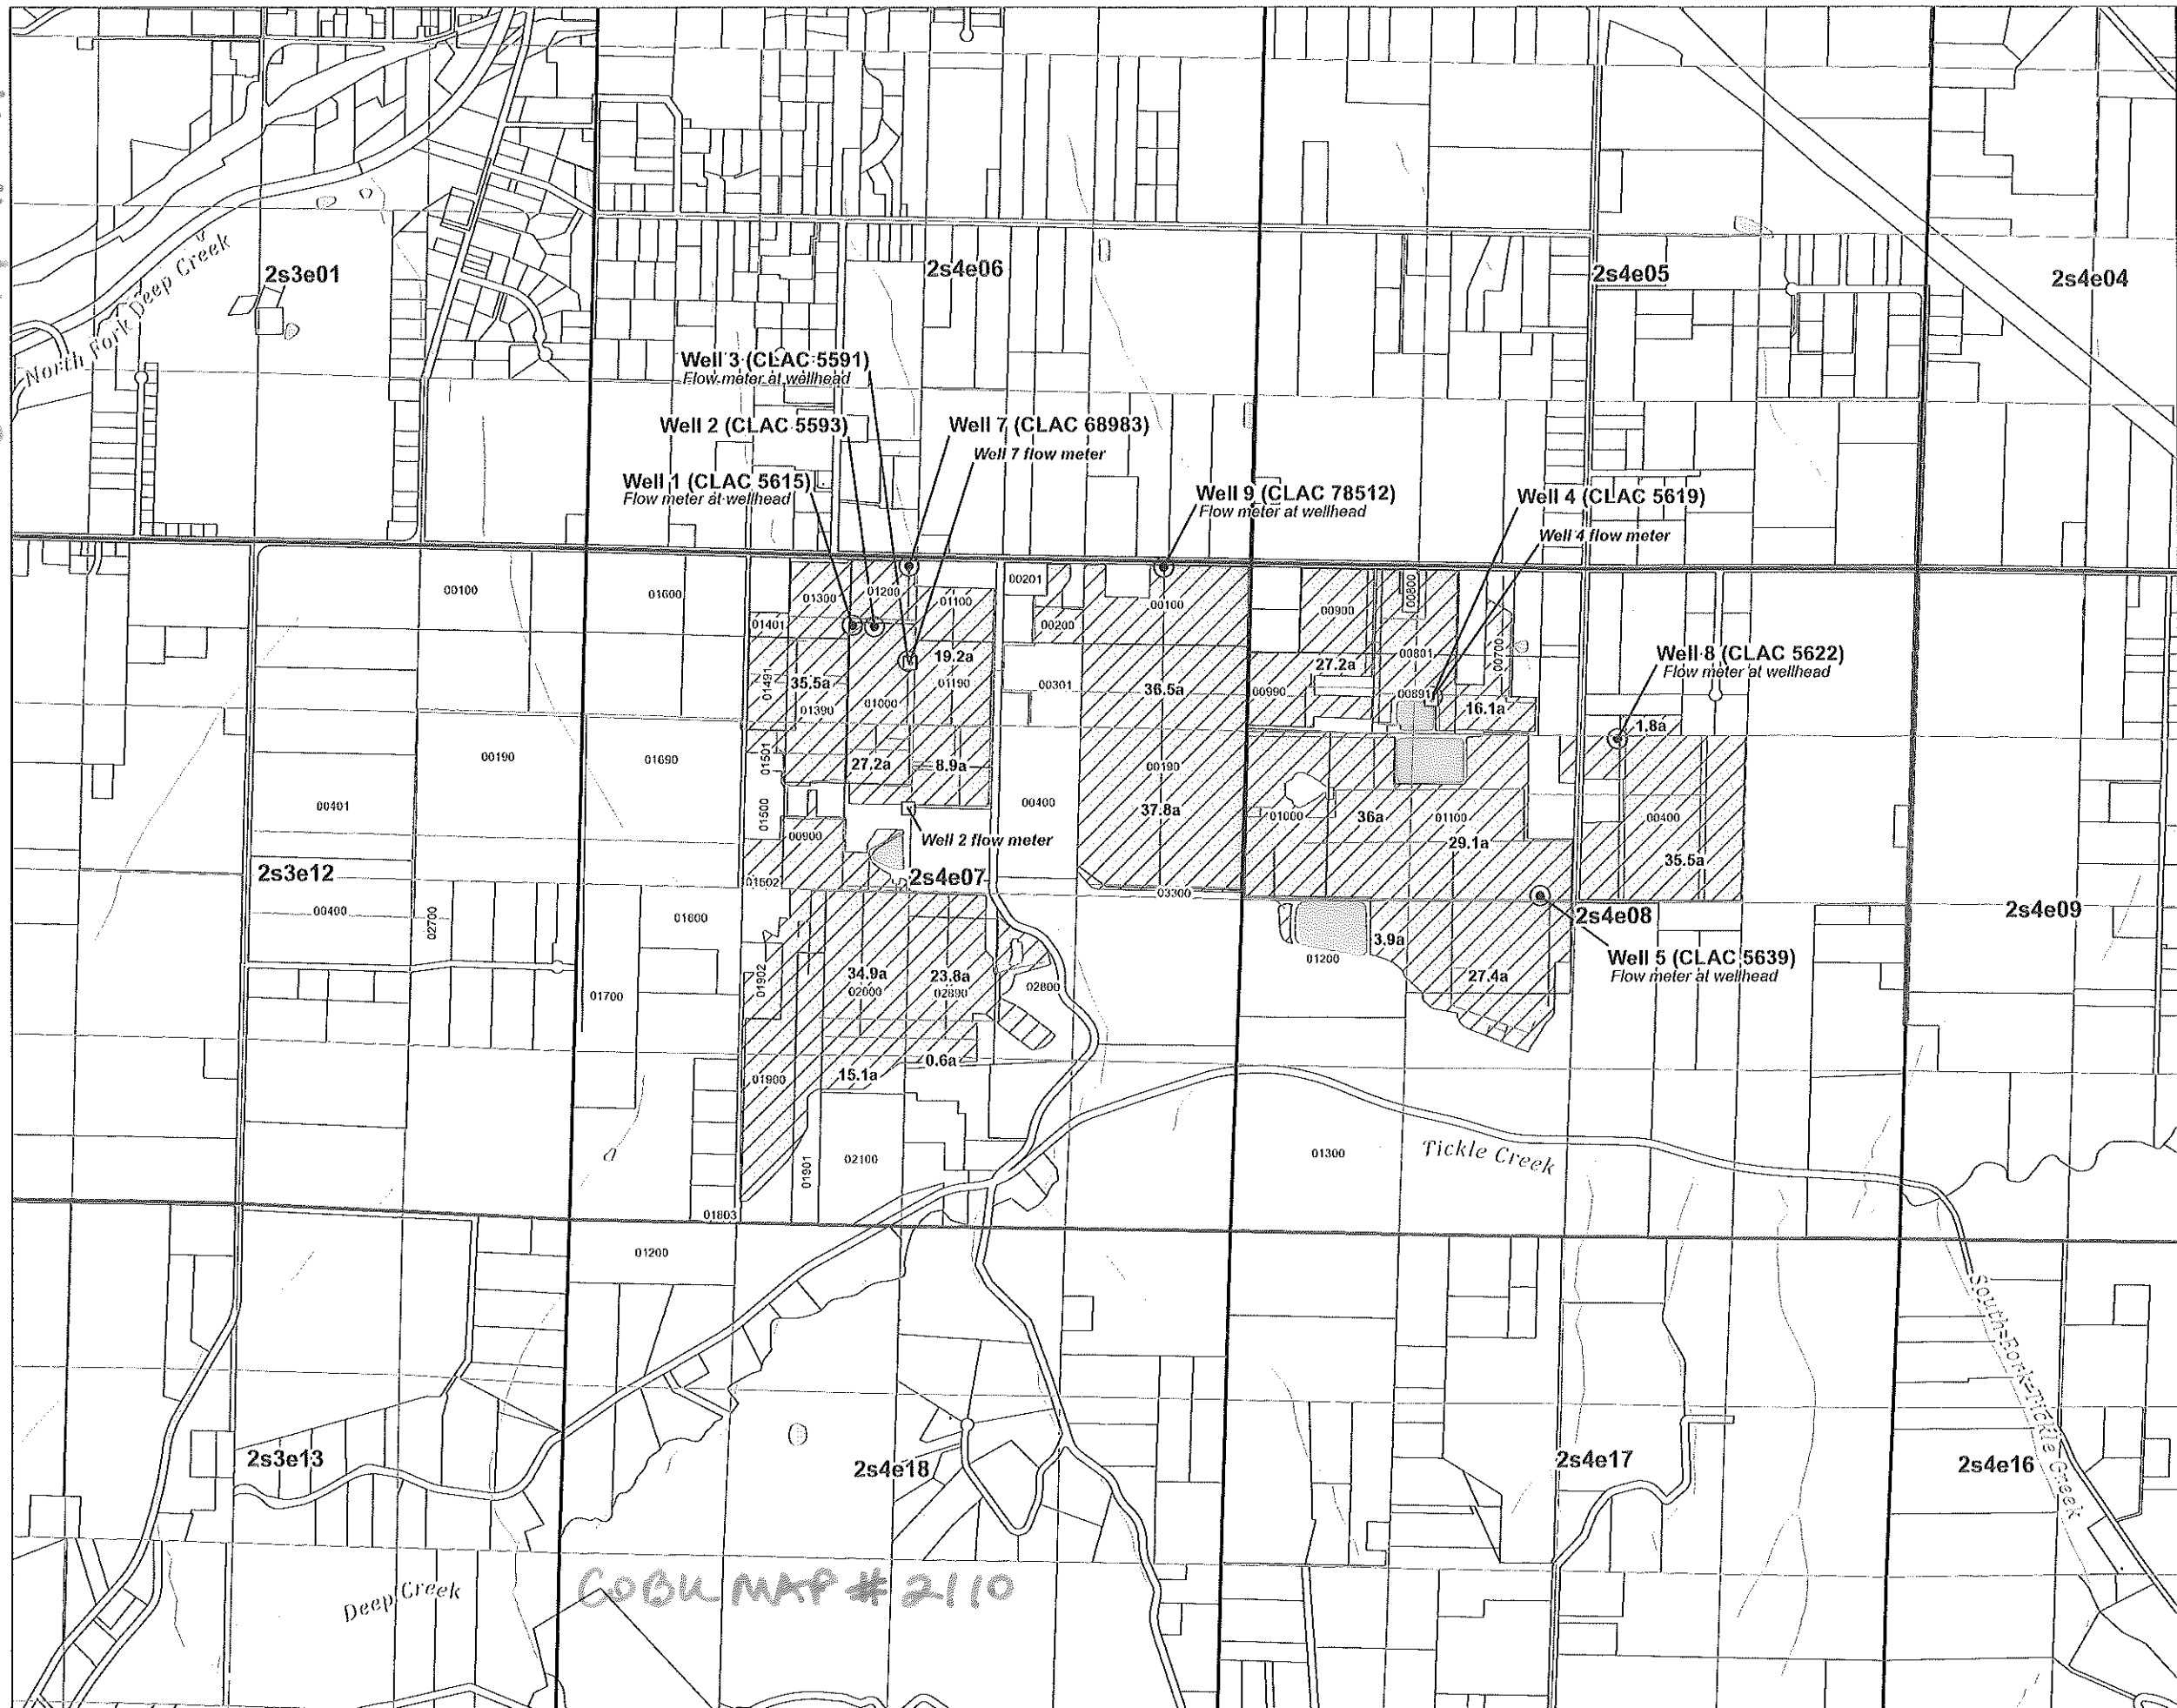


- LEGEND**
- Point of Appropriation (POA)
 - Remote Flow Meter
 - Place of Use (POU)
 - Tax Lots
 - System Mainlines

Hydrology
Perennial
Intermittent

POD Location Description

Well 1 (CLAC 5615): Located 525 feet South and 2165 feet East from the NW corner of Section 7 (NENW), Township 2 South, Range 4 East (WM).
Well 2 (CLAC 5593): Located 535 feet South and 2335 feet East from the NW corner of Section 7 (NENW), Township 2 South, Range 4 East (WM).
Well 3 (CLAC 5591): Located 810 feet South and 2610 feet East from the NW corner of Section 7 (NENW), Township 2 South, Range 4 East (WM).
Well 4 (CLAC 5619): Located 1050 feet South and 1460 feet East from the NW corner of Section 8 (NENW), Township 2 South, Range 4 East (WM).
Well 5 (CLAC 5639): Located 2600 feet South and 2350 feet East from the NW corner of Section 8 (SENE), Township 2 South, Range 4 East (WM).
Well 7 (CLAC 68983): Located 60 feet South and 2600 feet East from the NW corner of Section 7 (NENW), Township 2 South, Range 4 East (WM).
Well 8 (CLAC 5622): Located 1360 feet South and 2330 feet West from the NE corner of Section 8 (SWNE), Township 2 South, Range 4 East (WM).
Well 9 (CLAC 78512): Located 105 feet South and 640 feet West from the NE corner of Section 7 (NENE), Township 2 South, Range 4 East (WM).

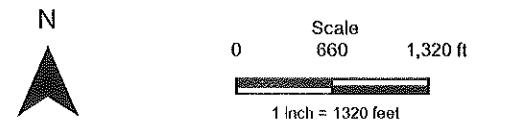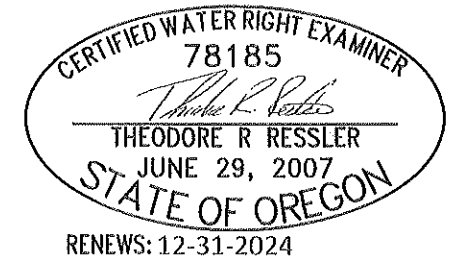

Date: 7/2/2024
Data Sources: BLM, OWRD, USGS, Clackamas Co.
Disclaimer: This map is not intended to provide legal dimensions or property ownership lines.

**Claim of Beneficial Use
Permit G-18836
(Application G-11241)**

A Water Right held by Iseli Nursery
Township 2 South, Range 3 & 4 East
Clackamas County

Received
JUL 15 2024
OWRD

