
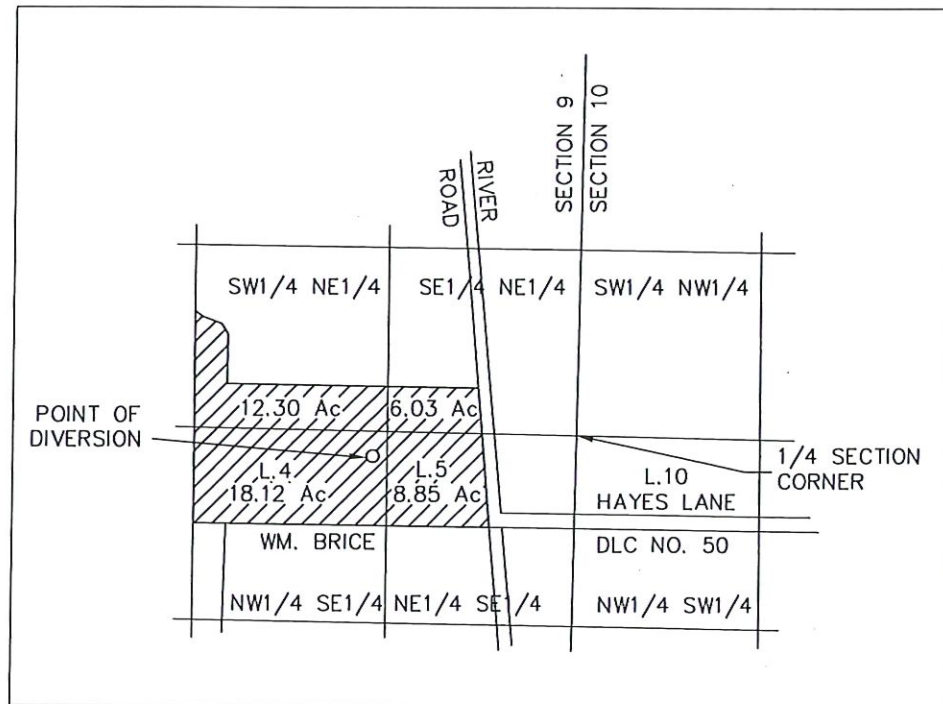


T.16S., R.4W., W.M.
SECTIONS 9
FINAL PROOF MAP
 APPLICATION NO. G-12486
 PERMIT NO. G-12184
LORENCE R. EDWARDS
TAX LOTS 800 & 806
MAP NO. 16-04-09
LANE COUNTY, OREGON
NOVEMBER 21, 2002

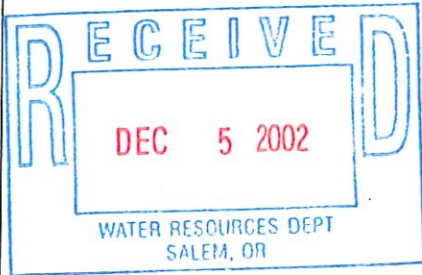

SCALE 1"=1320'

POINT OF DIVERSION

WELL IS 334 FEET SOUTH & 1420
 FEET WEST OF THE EAST 1/4
 CORNER OF SECTION 9. (45.30 Ac)

THIS MAP IS FOR THE PURPOSE OF
 LOCATING A WATER RIGHT AND IS NOT
 INTENDED TO PROVIDE LEGAL DIMENSIONS
 FOR LOCATION OF PROPERTY BOUNDARIES.

