


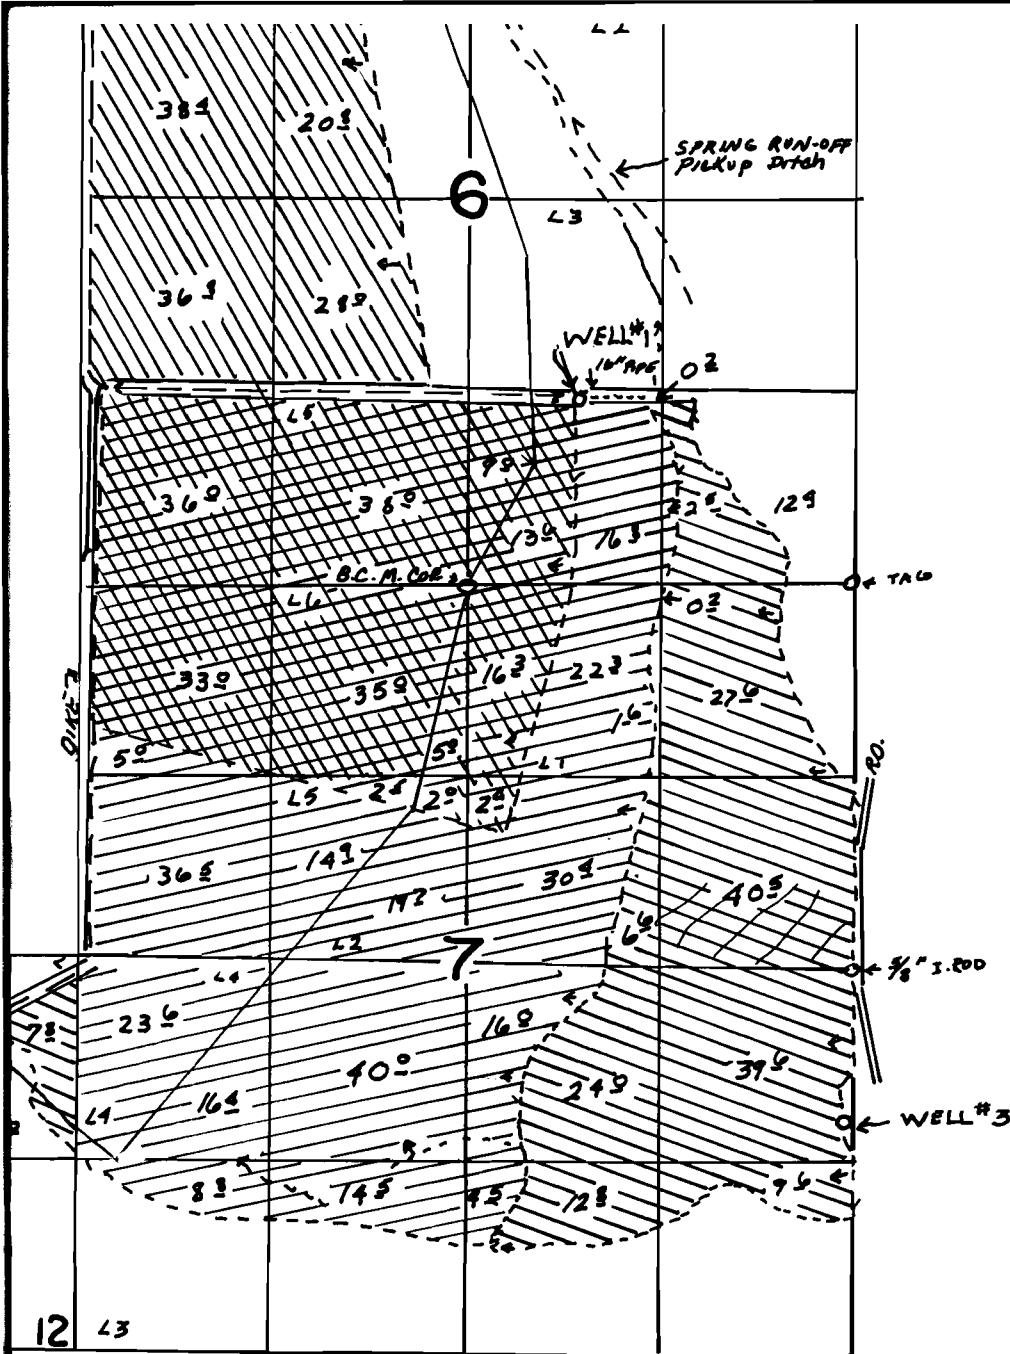


DE: #1 - 1250' N. 180' W FROM SE COR. SEC. 6
 #2 - 820' N. 900' W FROM NW COR SEC. 6
 #3 - 1030' S 10' W FROM E 1/4 COR. SEC 7


G-2907 Part Cam. H. S.

ROUND LAKE

MENADER LINE

- WELL#1 →  SUPPLEMENTAL
- WELL#2 →  SUPPLEMENTAL
- WELL#3 →  SUPPLEMENTAL
-  PRIMARY

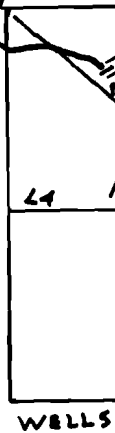

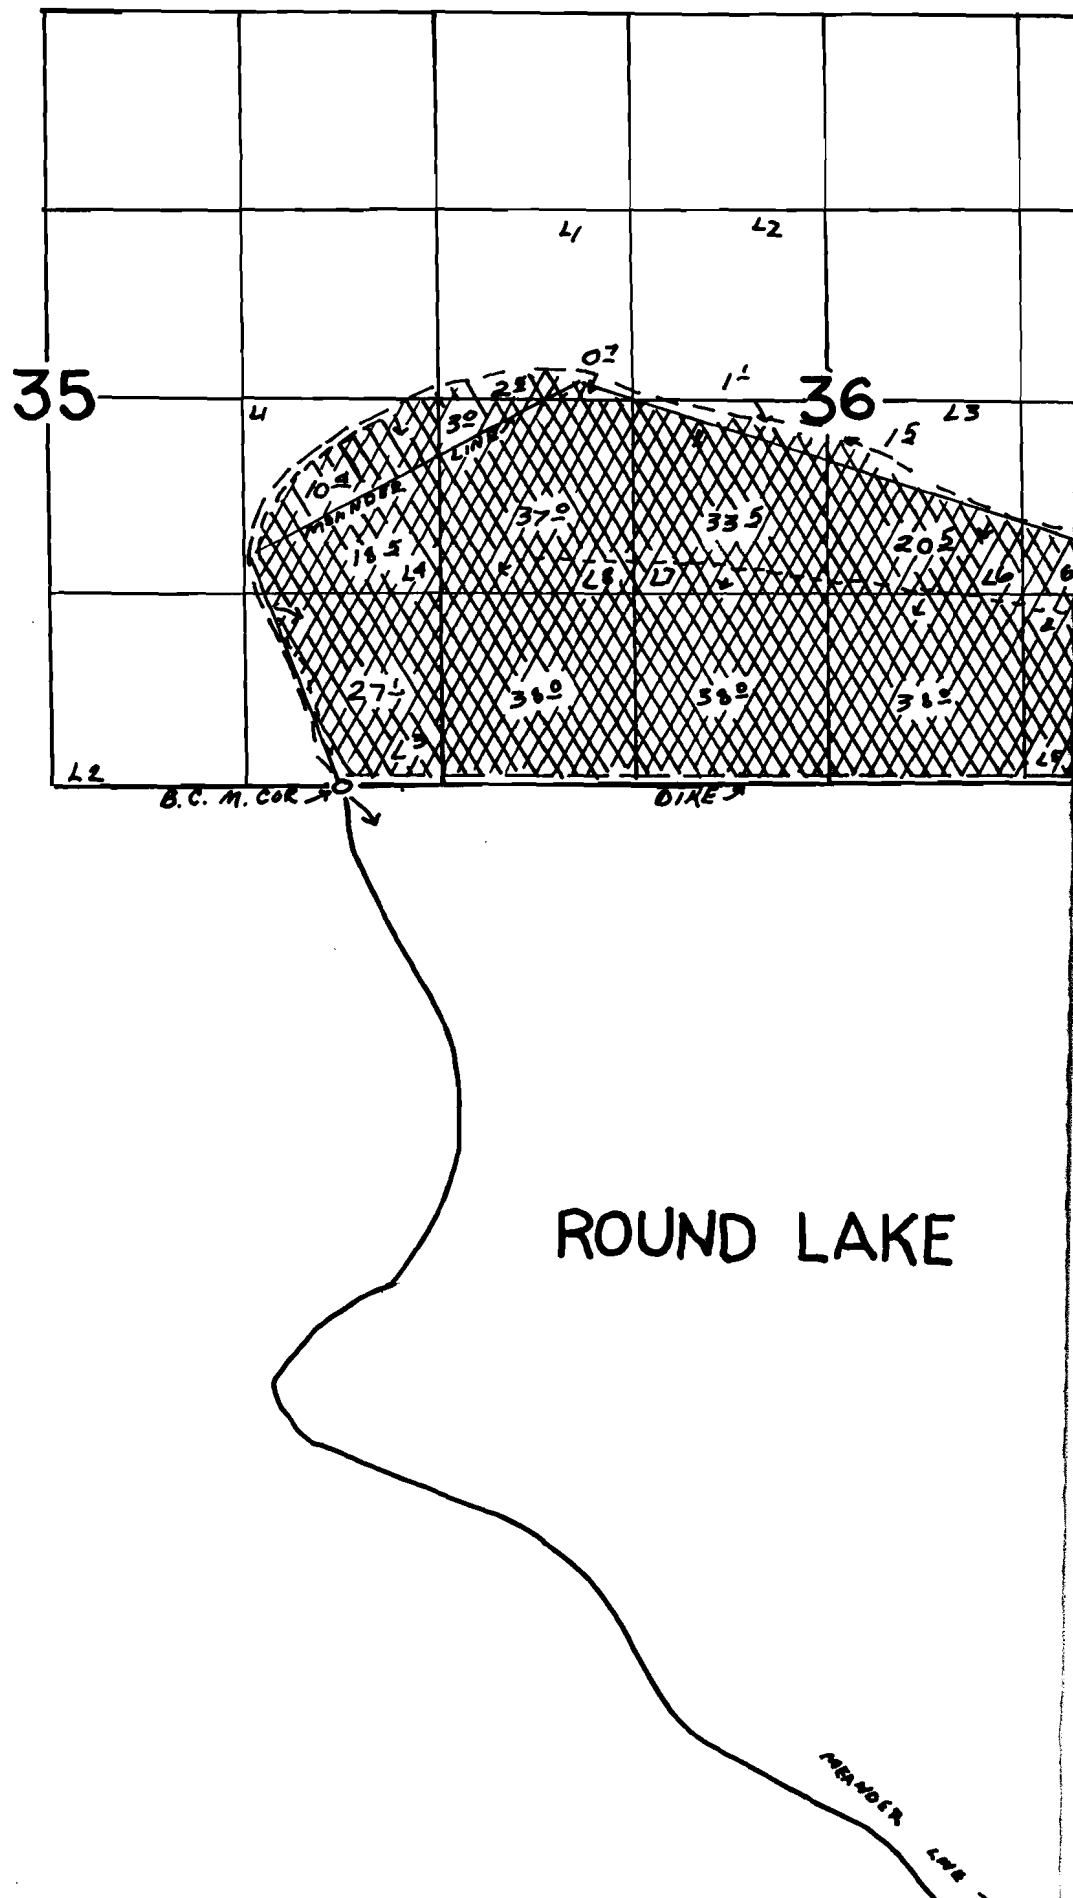

7 & 8 E.W.M.

