


T.58&6 S.R.58&6 W.W.M.

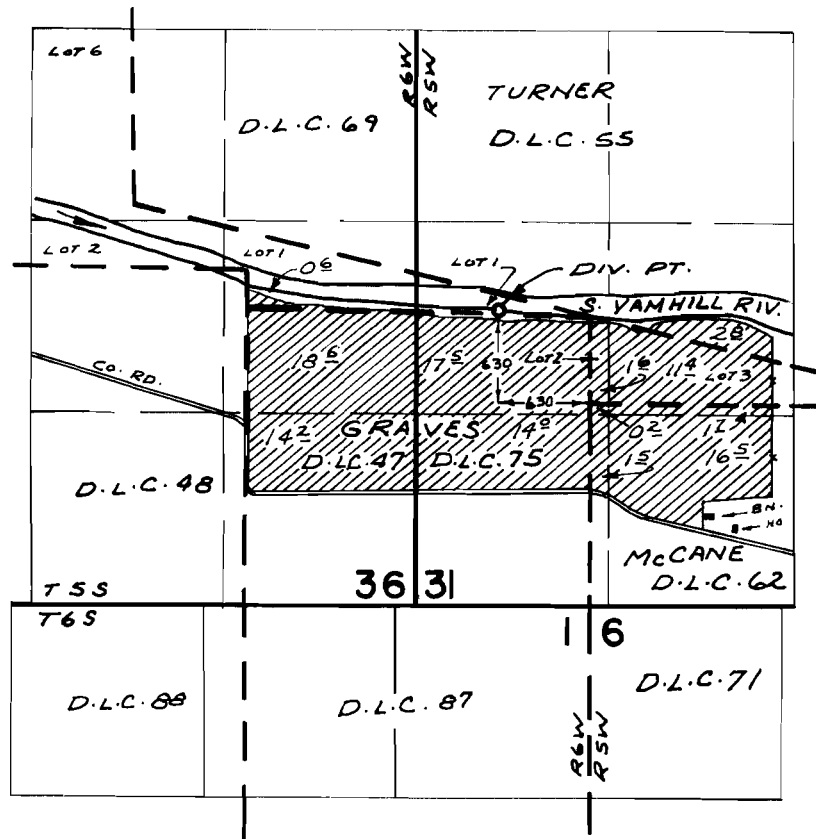


FINAL PROOF SURVEY
UNDER

Application No. 46441... Permit No. 34700...
IN NAME OF

OTTO P. BRANDT

Surveyed FEB. 2, 1973, by R. MUCKEN

Transfer Application - Certificate 57371 - Hurst

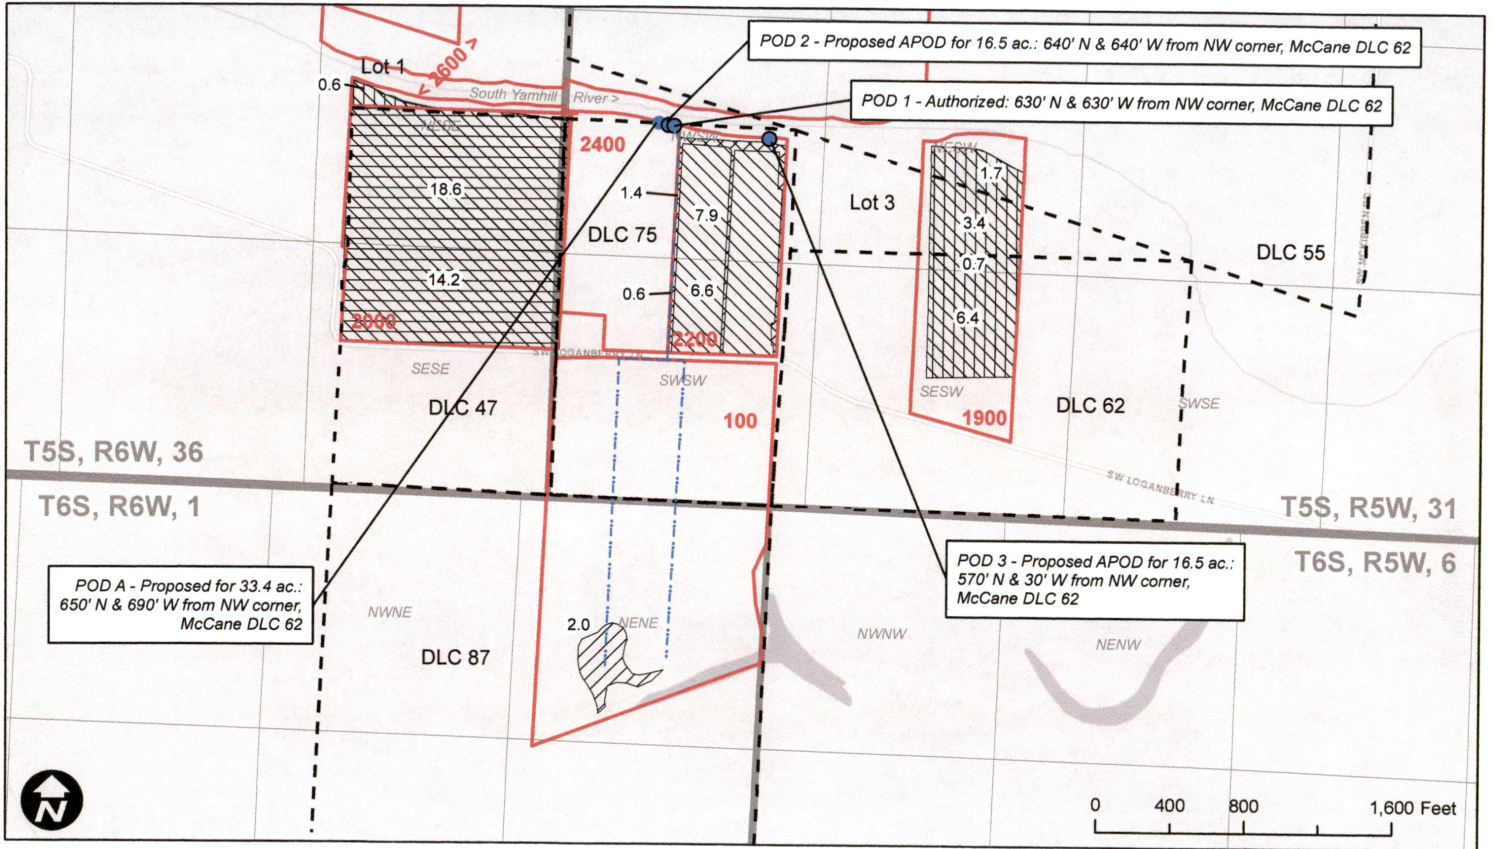

Legend


- | | | | |
|--------------------------------|-------------------------|-----------------------|---------|
| Cert. 57371 From POU | Cert. 57371 POD Change | Cert. 57371 No Change | DLC |
| Cert. 57371 To POU/APOD Change | Cert. 57371 APOD Change | Mainline | Tax Lot |

WILL MCGILL SURVEYING LLC

RECEIVED
MAR 17 2023
OWRD



Transfer Application - Certificate 56862 - Hurst

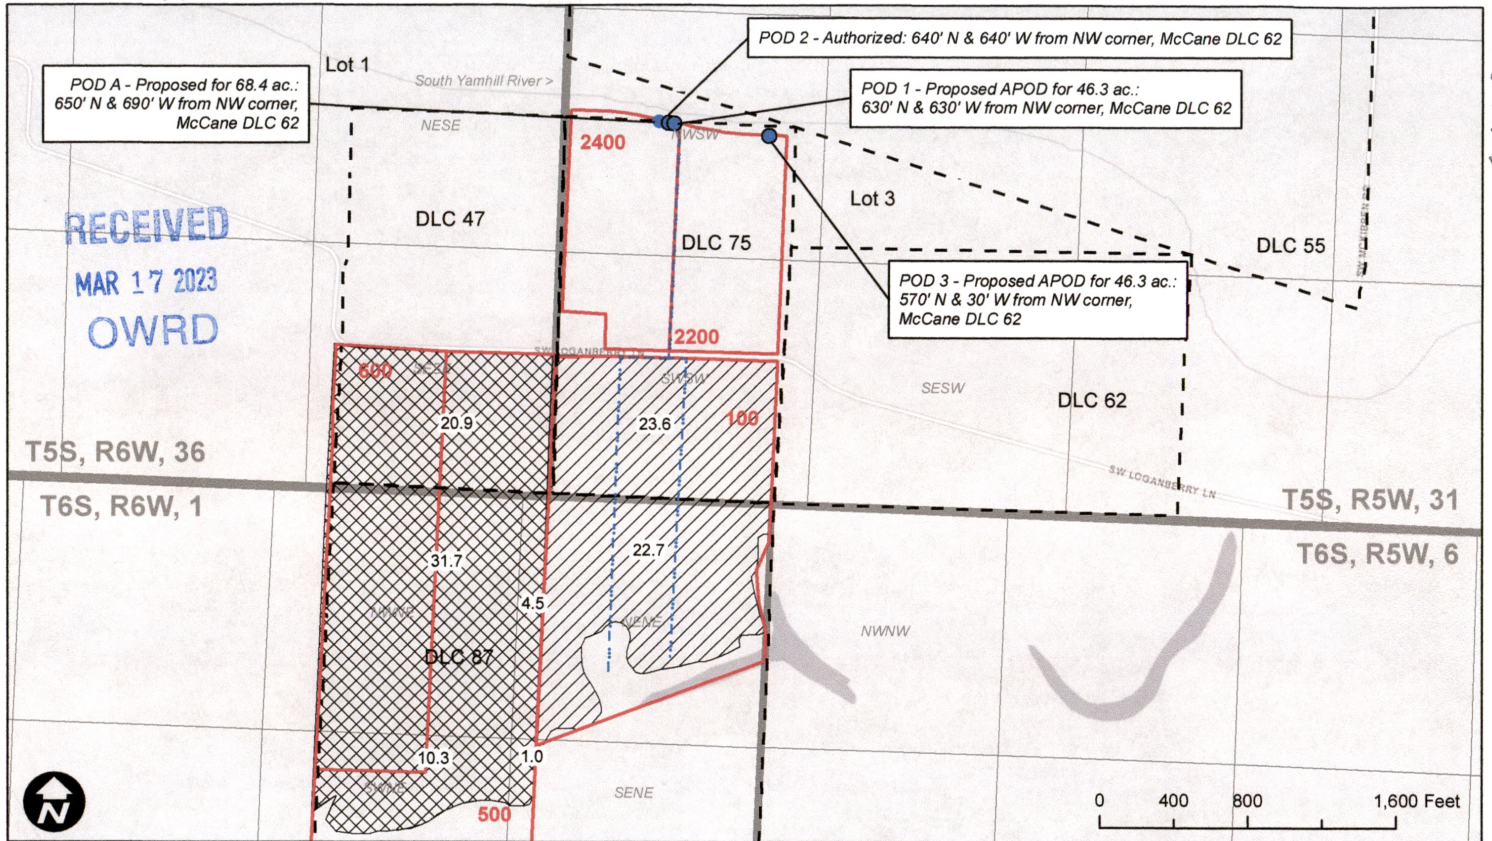


Legend

- Cert. 56862 POD Change
- Mainline
- DLC
- Cert. 56862 APOD Change
- Tax Lot

WILL MCGILL SURVEYING LLC



Transfer Application - Certificate 45979 - Hurst

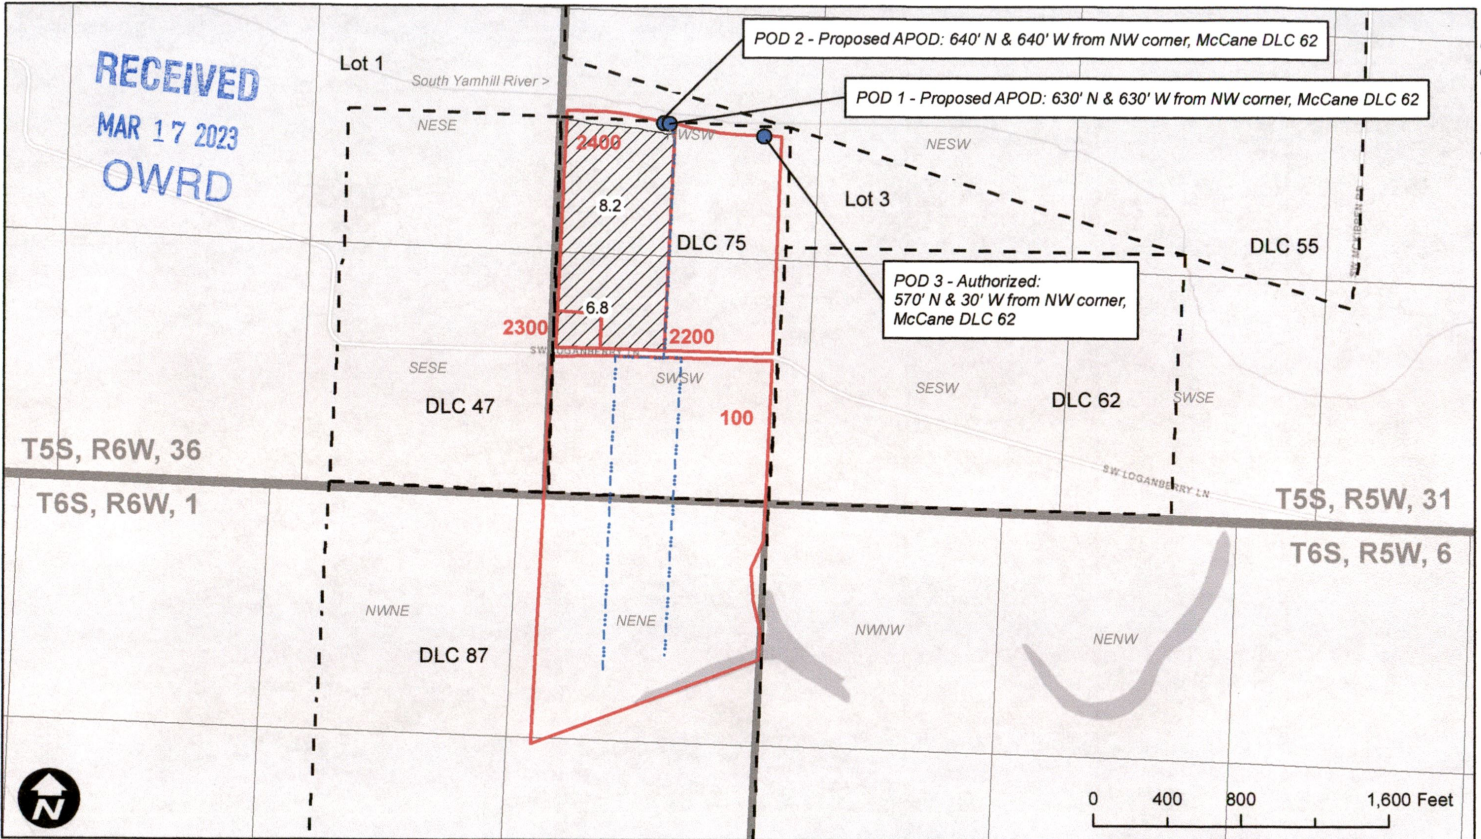

Legend

Cert. 45979 APOD Change
 Mainline
 Tax Lot
 DLC

WILL MCGILL SURVEYING LLC

