

APPLICATION NO. G-14687
PERMIT NO. G-13729
TOWNSHIP 1 SOUTH / RANGE 2 WEST / SECTION 23 NW1/4 NW1/4



THIS MAP IS NOT INTENDED TO PROVIDE LEGAL DIMENSIONS OR LOCATIONS OF PROPERTY OWNERSHIP LINES.

15

14

550 FT.

208 FT.

SW 229th Ave

SW Murphy Ln

POD 1 - Well

Hydrant & Meter

1-1/4" PVC w/ Risers @ 20' O/C

4.4 ac

TAX LOT 1S2230000601


22

23

Place of Use

Legend

- POD 1 - WELL
- ELEV. CONTOUR (ft)
- ROAD
- SECTION LINE

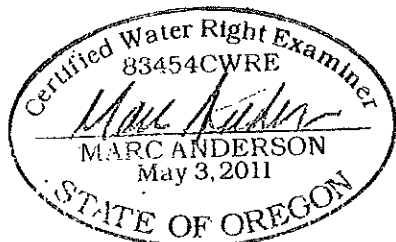

Expires 12/31/21

170

SW Rosedale Rd

1" = 400 feet

0 200 400 800 1,200 Feet