


CLAIM OF BENEFICIAL USE MAP

LOCATED IN SECTION 29, TAX LOT 1300, TOWNSHIP 1 SOUTH,
RANGE 2 WEST, DLC 50, W.M., WASHINGTON COUNTY, OREGON.

APPLICATION
G-15029

PERMIT
G-13823

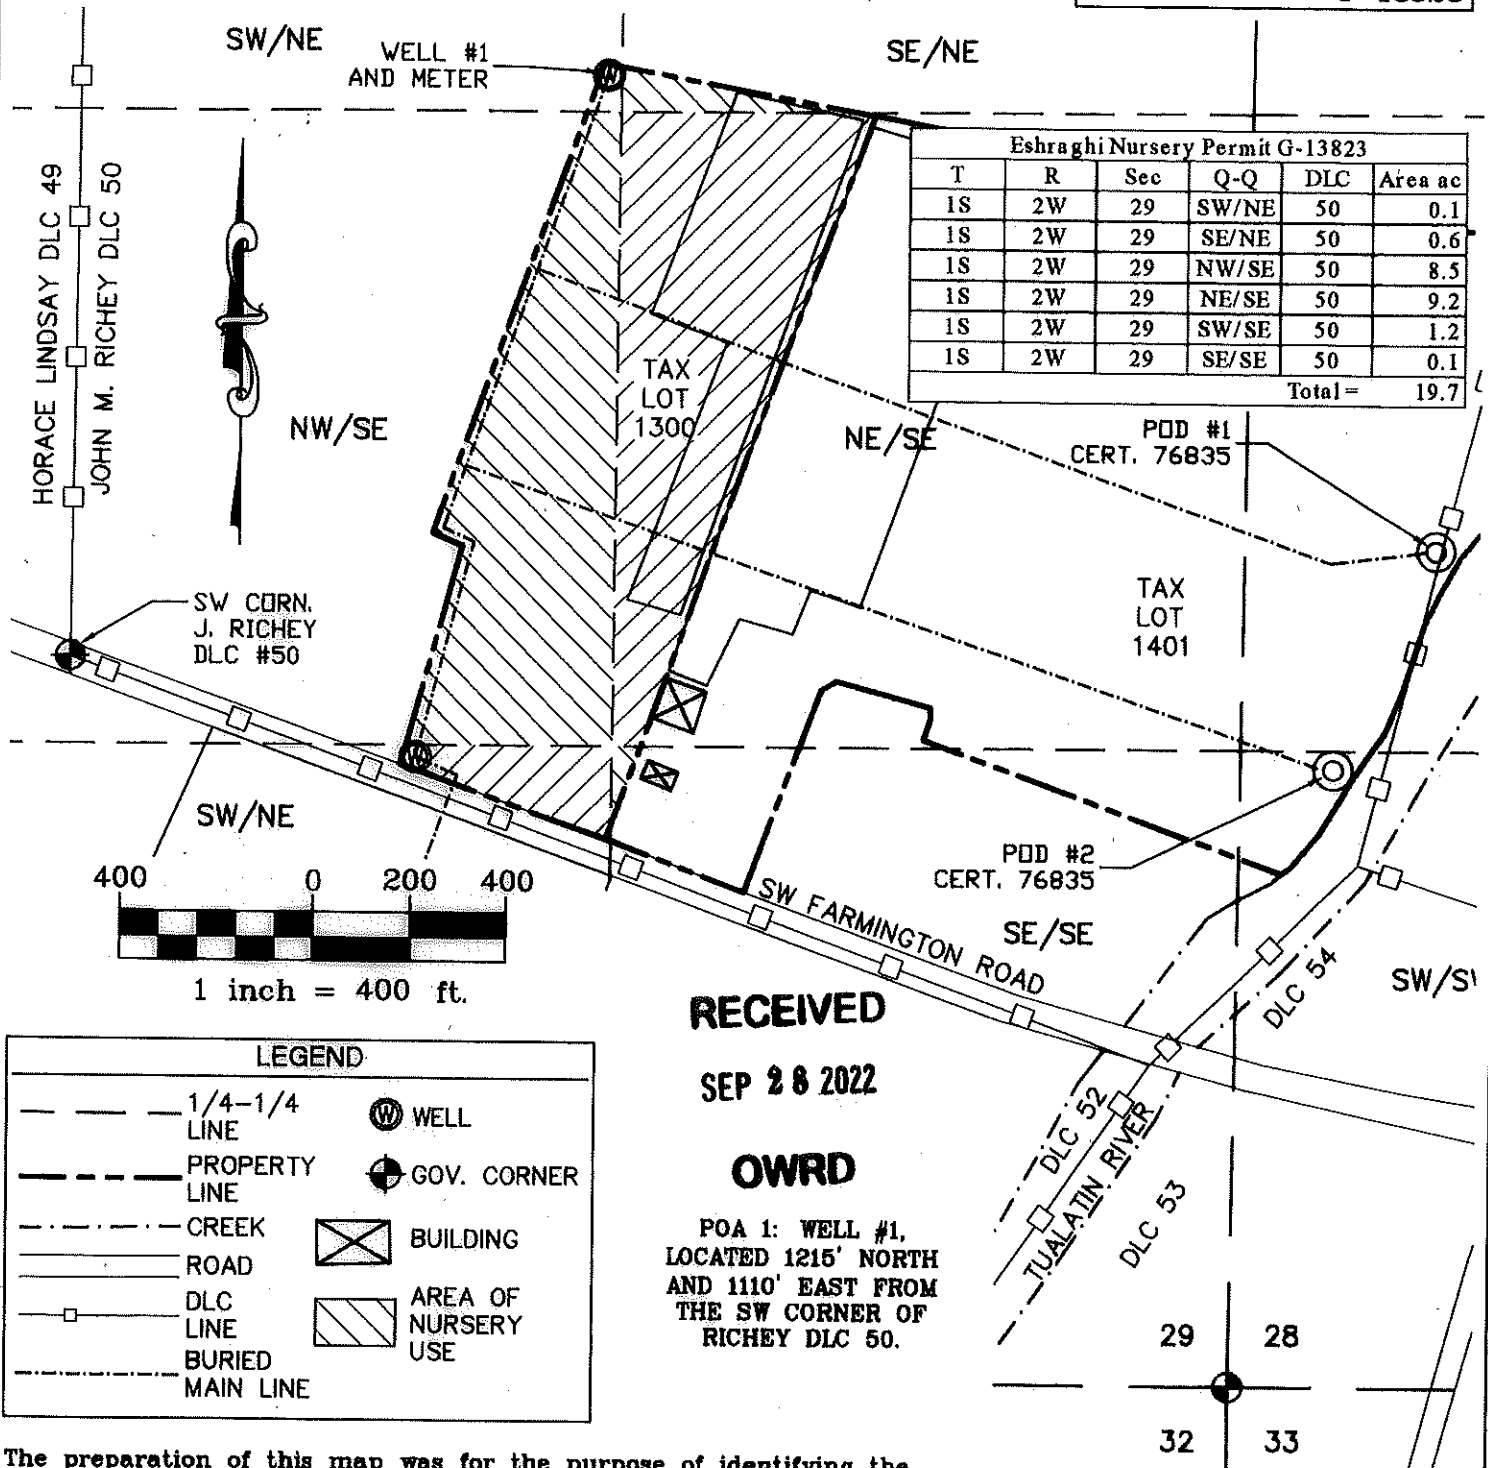

The preparation of this map was for the purpose of identifying the location of the Water Right only and has no intent to provide dimensions or location of property ownership lines.



ENGINEERING * LAND SURVEYING
FORESTRY * PLANNING * WATER RIGHTS

JOB# 322-055, REVISED 8-24-22
DRAWING : ESHRAHGI COBU MAP.DWG

2318-B PACIFIC AVENUE TEL: (503) 357-5717
FOREST GROVE, OR 97116 FAX: (503) 357-5698

