

# Crook County

T 15S

R 16E

Sec.5


Tax Lot 13800

E-RECEIVED

12/20/2024

OWRD

SE Of The SW

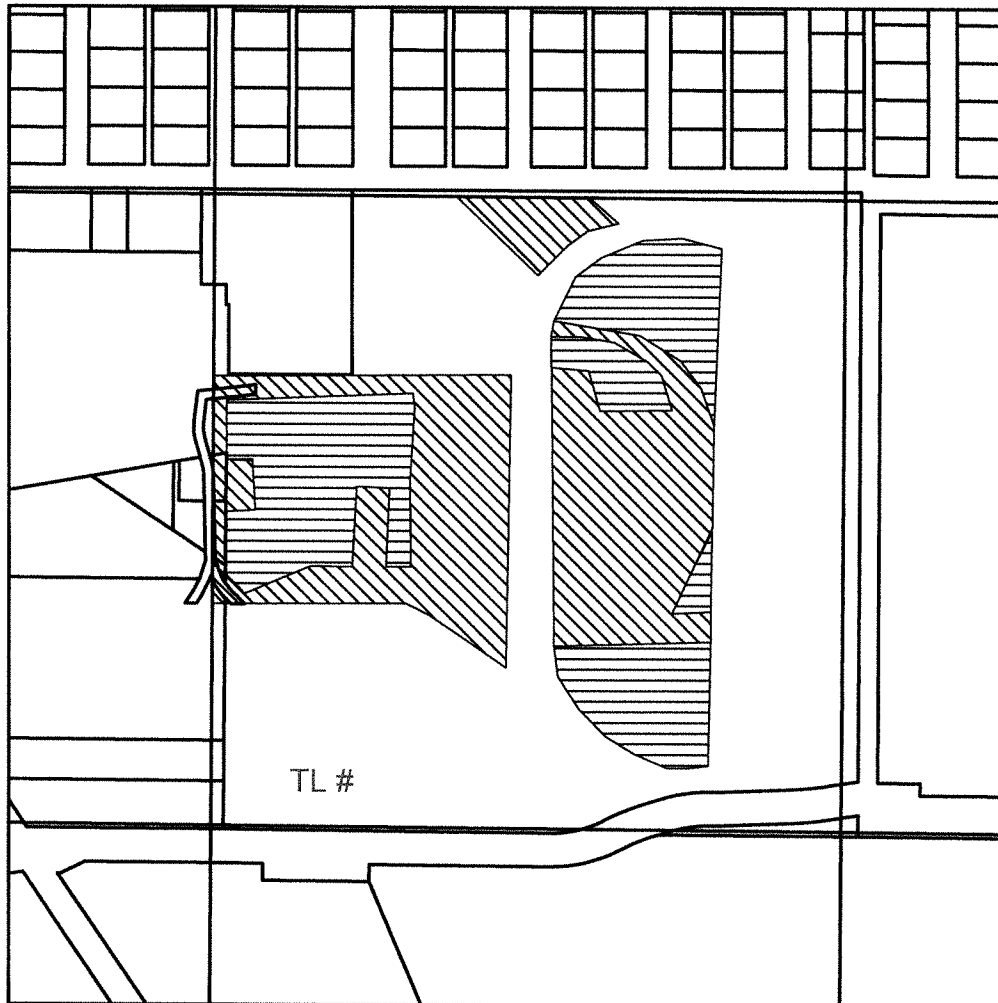
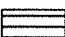


Prepared:


1 inch equals 400 feet

District Internal Notice #:

Certificate #: 48584

-  48584 Canceled  
 48584 Supplemental

## Cancellation & Supplemental

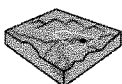

Crook County GIS  
GEOGRAPHIC INFORMATION SYSTEMS

To be

**Cancelled Acres: 8.15**

Diminished to

**Supplemental Acres: 5.85**