


RECEIVED

AUG 02 2023  
OWRD  
SALEM, OREGON

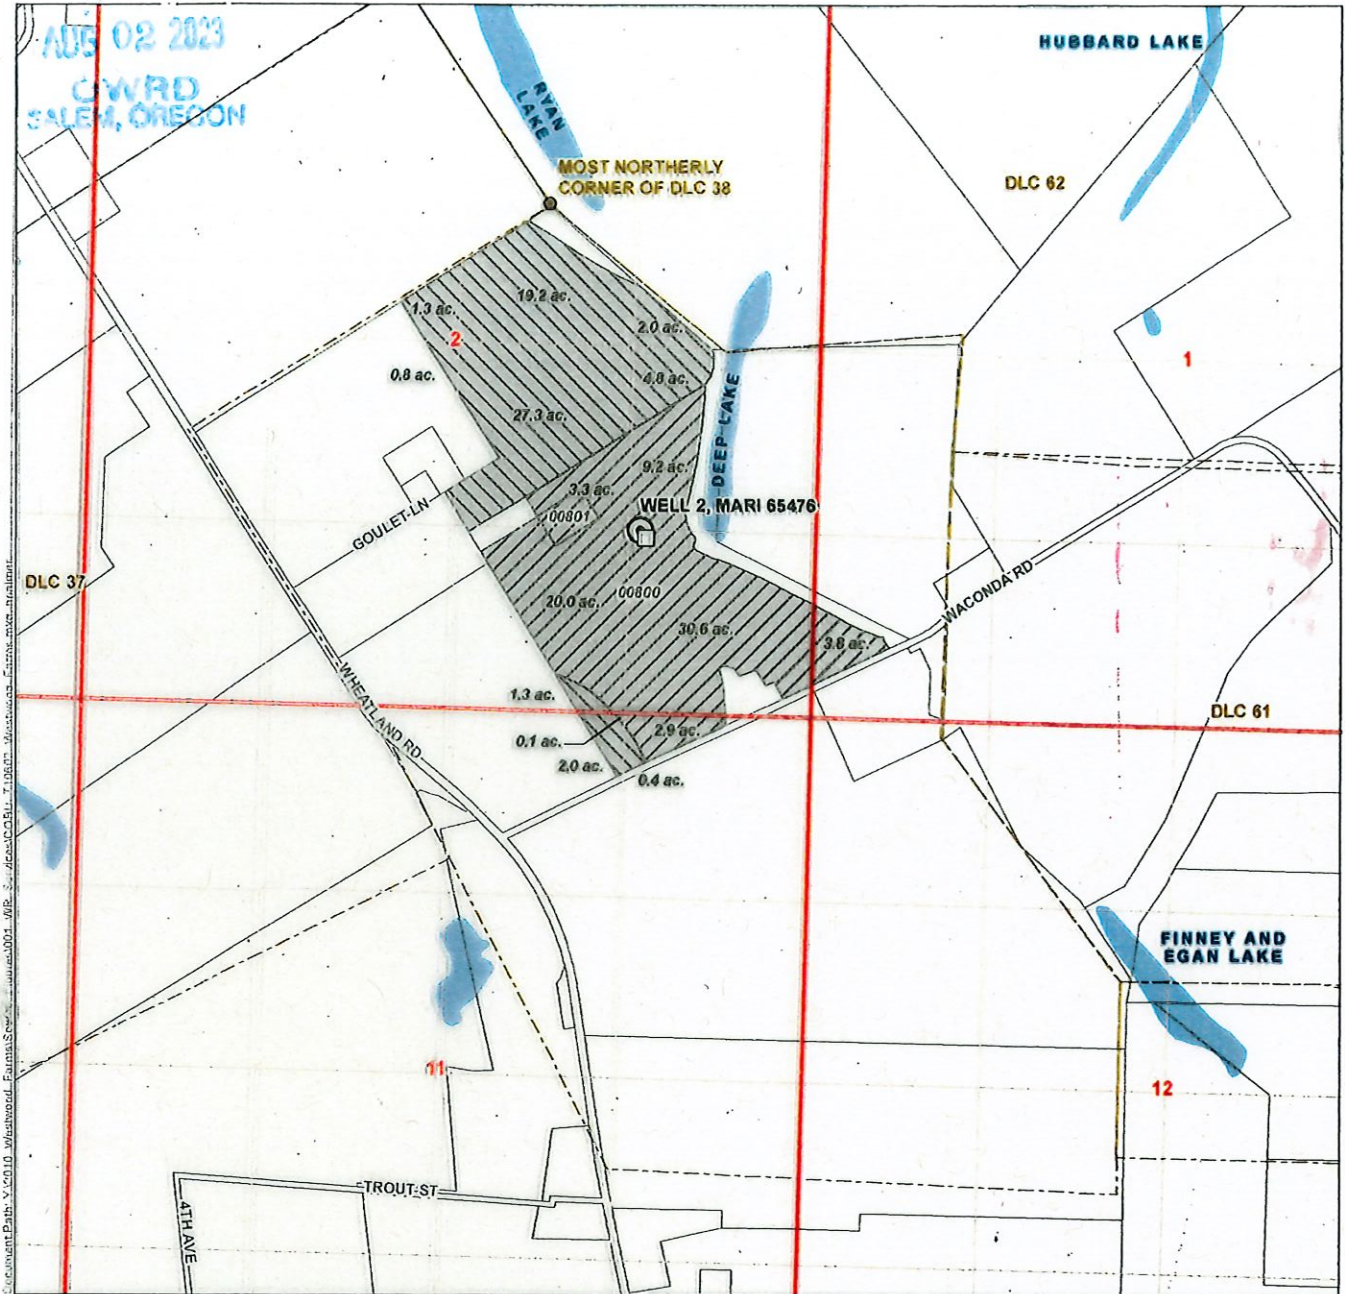


**LEGEND**

- |                                 |                           |
|---------------------------------|---------------------------|
| ● Point of Appropriation (POA)  | All Other Features        |
| □ Meter                         | Donation Land Claim (DLC) |
| <b>Place of Use (POU)</b>       | Tax Lot                   |
| ▨ Certificate 47856, 59.1 acres | Watercourse               |
| ▨ Certificate 61435, 69.9 acres | Waterbody                 |

**Claim of Beneficial Use Map**  
**Westwood Farms, Inc.**  
**T-10602**

Township 6 South, Range 3 West (W.M.)

**CERTIFIED WATER RIGHTS EXAMINER STAMP**

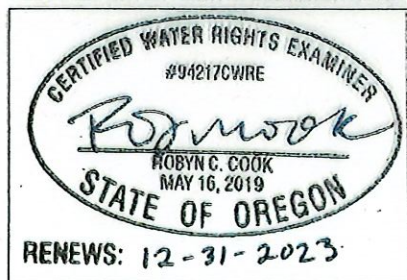

**LOCATION DESCRIPTION**

**Well 2**  
Located 2310 feet South and 660 feet East from the most Northernly corner of DLC 38, Township 6 South, Range 3 East (W.M.)

**DISCLAIMER**  
This map was prepared for the purpose of identifying the location of a water right only and it is not intended to provide legal dimensions or location of property ownership lines.

Date: April 28, 2023  
Data Sources: BLM, ESRI, OWRD, USGS



0 660 1,320  
1 inch = 1,320 feet

