

CLAIM OF BENEFICIAL USE MAP

FOR APPLICATION G-15576
RJ SANFORD TRUST
TOWNSHIP 30 SOUTH RANGE 10 EAST, W.M.
SECTIONS 9, 10, & 11, TAX LOT 201
ALL IN KLAMATH COUNTY, OREGON

Received
DEC 24 2024
OWRD

◆ GOVERNMENT CORNER MONUMENT

— SUPPLY CANAL




905.6 ACRES 'IS' FROM
PERMIT G-15112, AS SHOWN.

● WELL (KLAM 53513)

LOCATED IN THE NE 1/4 NW 1/4 SECTION
11 AND 1125 FEET SOUTH AND 1160 FEET
WEST FROM THE N 1/4 CORNER THEREOF.
FLOW METER IS LOCATED ON THE DELIVERY
PIPE 10 FEET SE'LY FROM THE WELL.

SCALE: 4 INCHES = 1 MILE

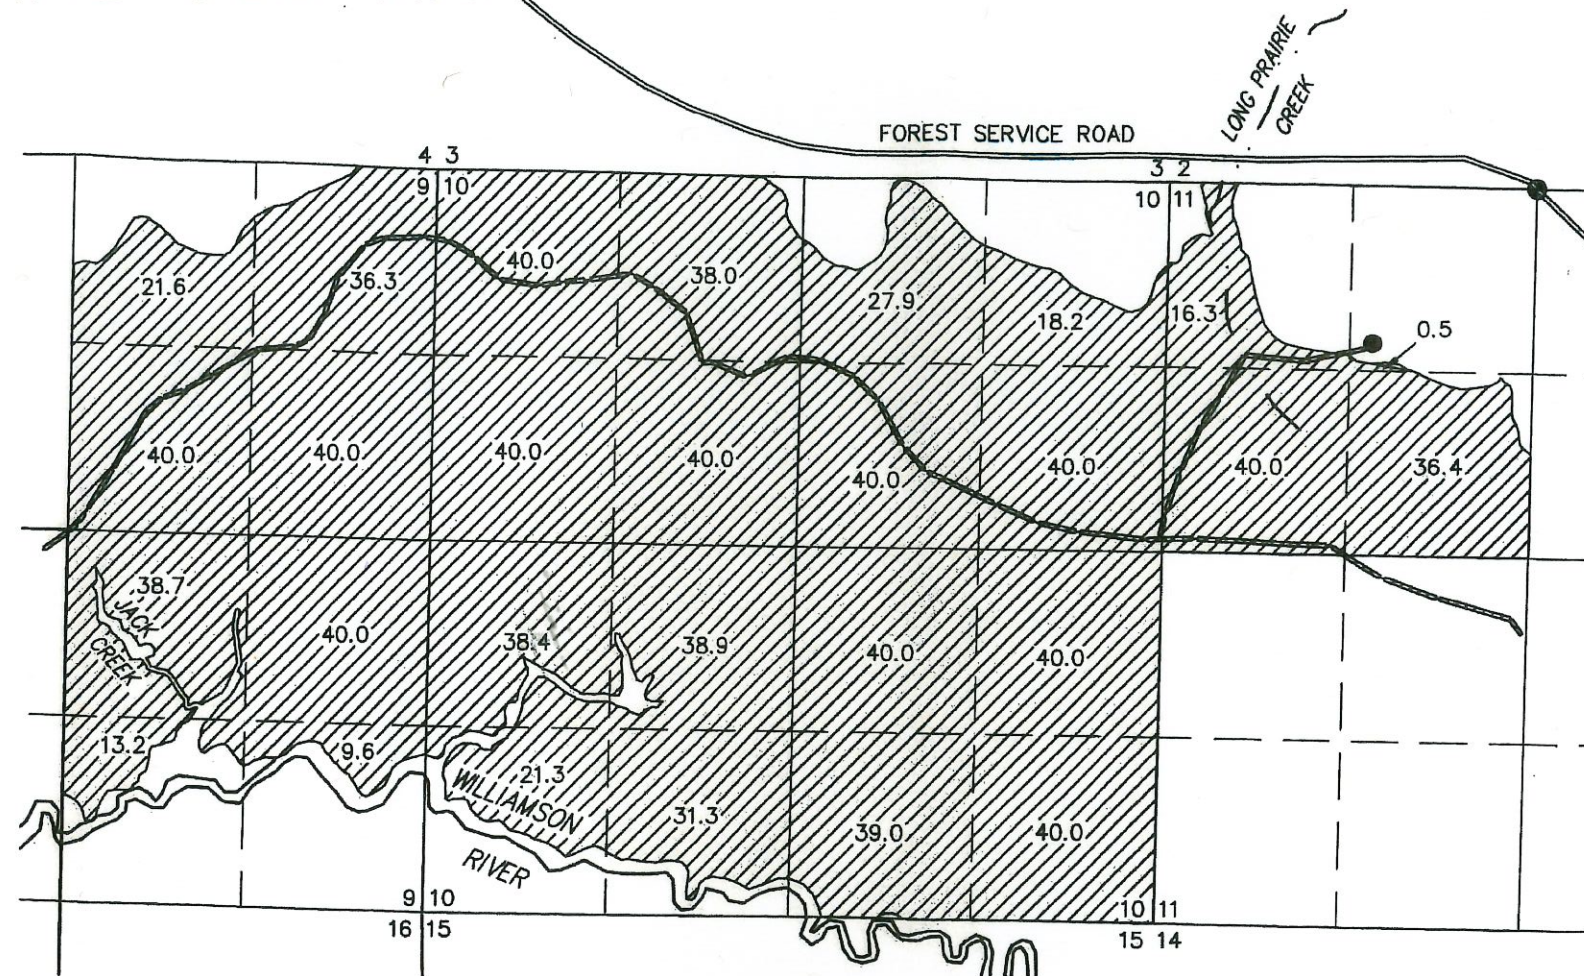

PREPARED FOR:

RJ SANFORD TRUST
760 LAZY HEART LANE
FALLON, NV 89406

PREPARED BY:



ALL POINTS ENGINEERING AND SURVEYING, INC.
P.O. BOX 767 TERREBONNE, OR 97760
(541) 548-5833 www.APEandS.com

THIS MAP IS FOR THE PURPOSE OF
LOCATING A WATER RIGHT ONLY AND HAS
NO INTENT TO PROVIDE LEGAL DIMENSIONS
OR THE LOCATION OF PROPERTY LINES



RENEWAL DATE: 12/31/2024

COBU MAP # 2131