
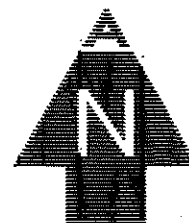
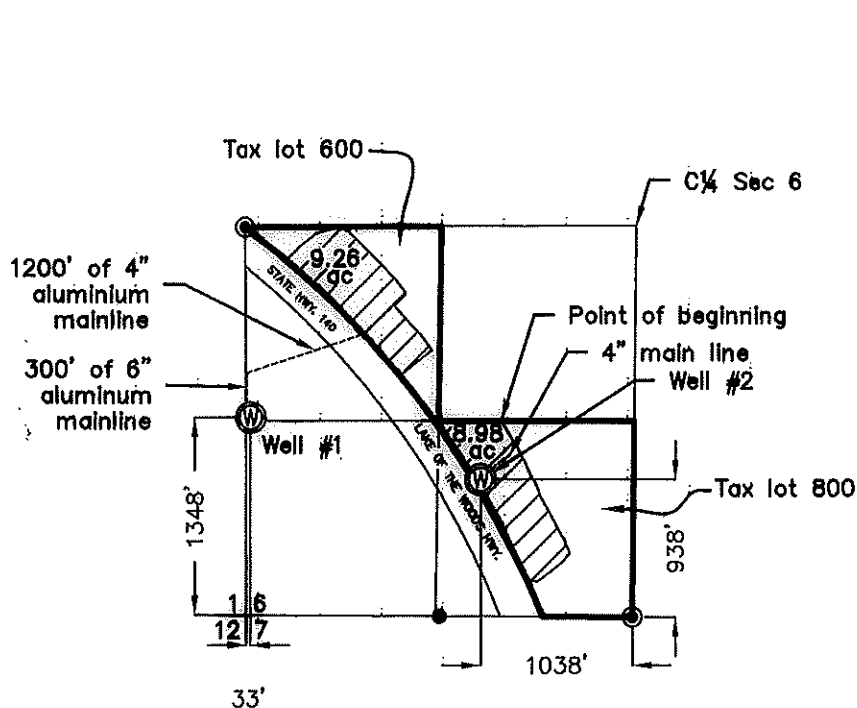


FINAL PROOF MAP
TO ACCOMPANY
CLAIM OF BENEFICIAL USE
IN THE NAME OF
JERRY A. & PATRICIA E. SCHUMANN
APPLICATION #G12380, PERMIT #G12479

T.39S., R.09E., W.M.
LOCATED IN THE NW¼SW¼ & SE¼SW¼ SEC. 6,
KLAMATH COUNTY, OREGON
A WELL IN THE KLAMATH RIVER BASIN

TAX MAP 3909-06 TL 600 & 800

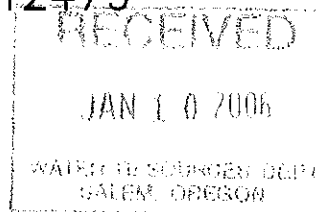

SCALE: 1" = 1320

LEGEND

- Found monuments per CS 5038
- Found monument per CS 3544 & CS 3573




Irrigated area


Mainline

THIS MAP IS FOR THE PURPOSE OF IDENTIFYING THE LOCATION OF THE WATER RIGHT ONLY AND HAS NO INTENT TO PROVIDE DIMENSIONS OR LOCATION OF PROPERTY LINES.

Basis of bearings is CS 5038

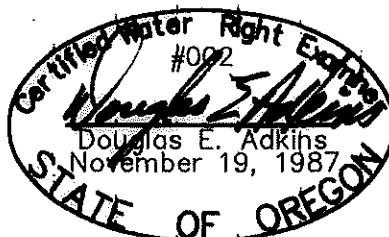

EXPIRES 12/31/07

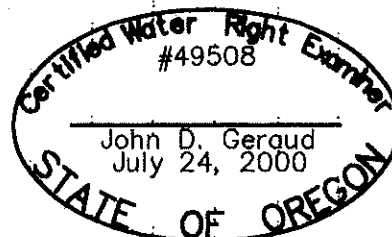

EXPIRES 6/30/03

Engineers ▲ Planners ▲ Surveyors

2950 Shasta Way • Klamath Falls, Oregon 97603 • (541) 884-4666 • FAX (541) 884-5335
October 16, 2002 Klamath Falls, OR • Medford, OR • Alturas, CA JOB No. 1435-0101