

## WELL LOCATIONS

- WELL #5(McCABE SOUTH) - NORTH 44.5' WEST 840.1'  
45°19'59.8676" N 117°59'49.2389" W
- WELL #6(MICHAELSON) - NORTH 2046.5' EAST 2858.4'  
45°20'19.5877" N 117°58'57.4409" W
- WELL #7(McCABE NORTH) - NORTH 1648.3' WEST 993.8'  
45°20'15.6986" N 117°59'51.3672" W

## LEGEND

- Authorized Well
- Lands currently irrigated from wells, McCabe South, McCabe North and Michaelson as approved under Permit G-13253 and T-8746.




SCALE: 1"=400'

CLAIM OF BENEFICIAL USE MAP FOR IRRIGATION UNDER PERMIT G-13253 AND T-8746 FOR MBD FARMS LLC

BY  
BAGETT-GRIFFITH & BLACKMAN  
2006 ADAMS AVENUE  
LA GRANDE, OREGON 97850

OCTOBER 1, 2022  
APPLICATION NO. G-14292  
PERMIT NUMBER: G-13253  
PERMIT AMENDMENT: T-8746

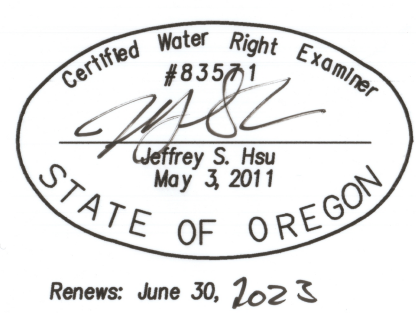

NOTE: The preparation of this map was for the purpose of identifying the location of the proposed water right and has no intent to provide dimensions or location of property ownership lines. Location information shown hereon was furnished by the applicant.

