



- Well
- Meter
- Pipeline
- ▨ Reservoir (Bulge-in-System)
- ▨ POU IM
- Section
- Quarter Quarter
- Tax Lot

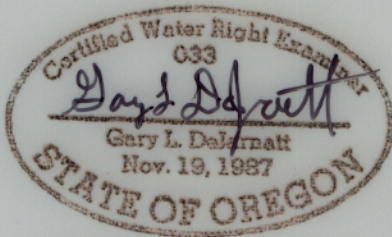


RENEWAL DATE 12/31/2025



**T14S R14E, WM
CROOK COUNTY, OR**

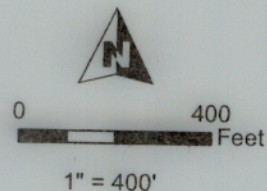

**Well #2 CROO 51925 Location:
730' N, 710' W of E 1/4 Cor Sec 30**

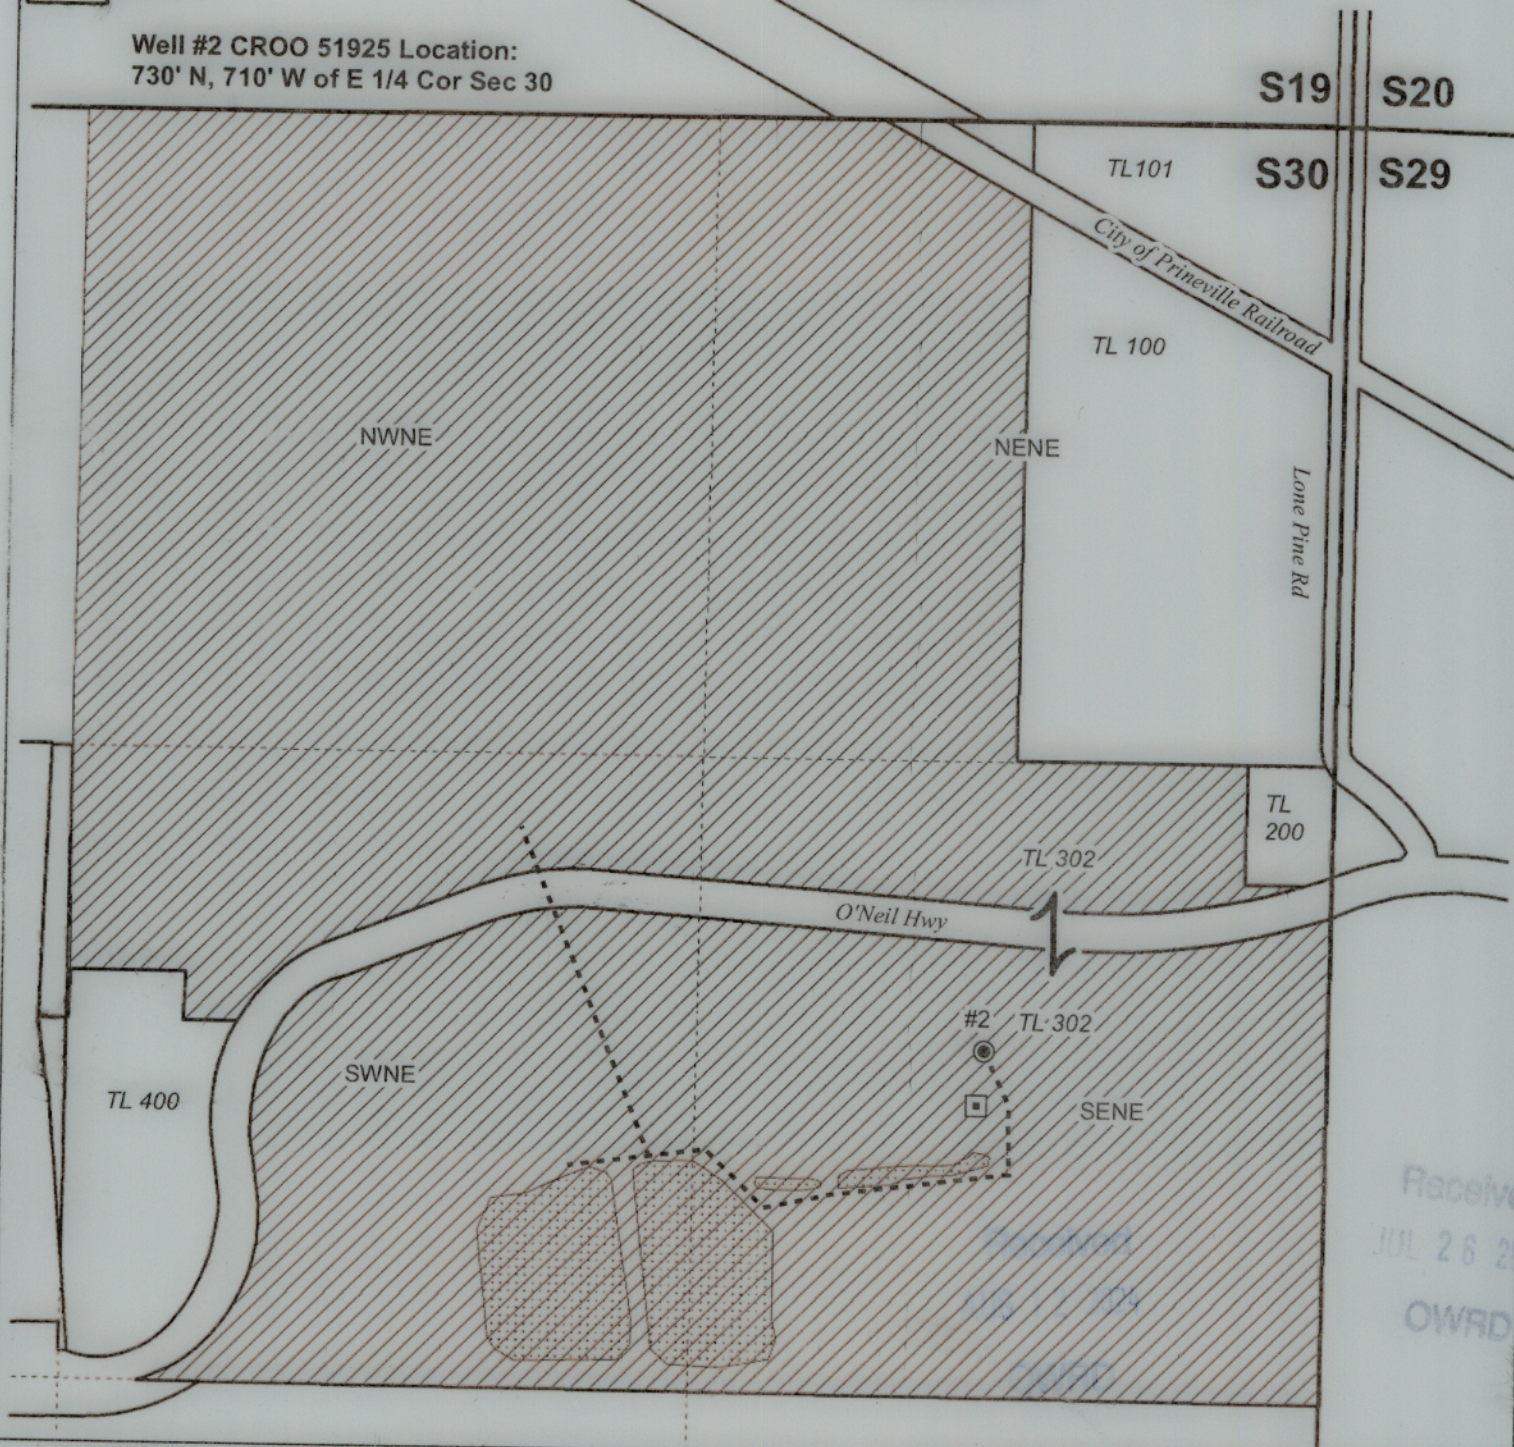

Received
JUL 26 2024
OWRD

**CLAIM OF BENEFICIAL USE MAP
O'NEIL VALLEY, LLC**

Date: 5/14/2024

T-8928

Project #23076

This map is not intended
to provide legal dimensions
or locations of property
ownership lines.

WATER RIGHT SERVICES, LLC

PO BOX 1830, BEND, OR 97709
WWW.OREGONWATER.US CCB # 197121
johnshort@usa.com 541-389-2837