





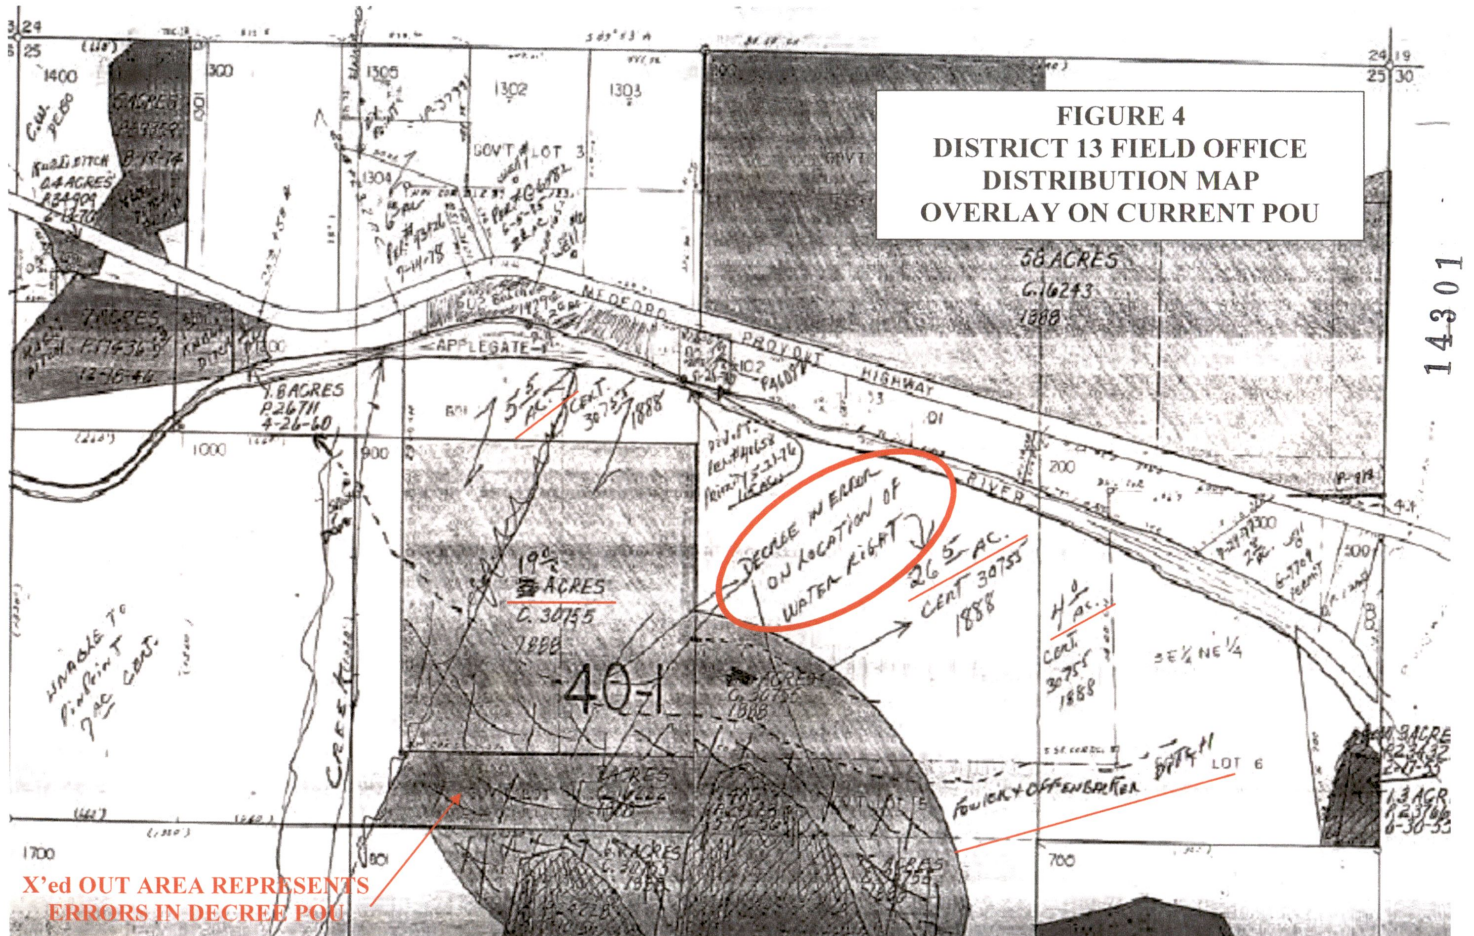

LESLIE & RACHAEL MARTIN
11777 HWY 238
JACKSONVILLE, OR 97530

C-30755 POD TRANSFER AND
POU CLARIFICATION

SECTION 25, TOWNSHIP 38 S
RANGE 4 W, W.M.
JACKSON COUNTY OREGON

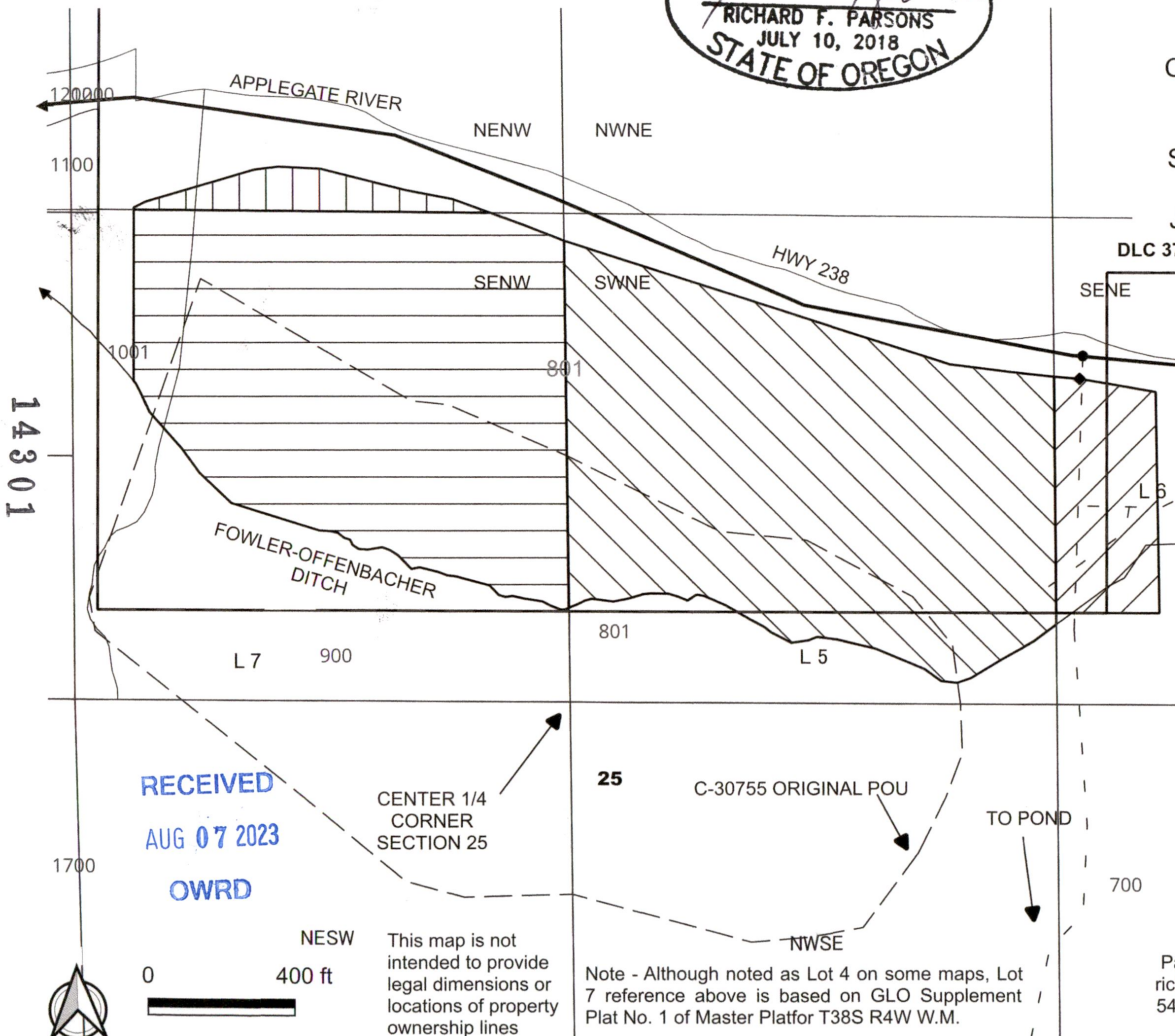

● RED LILY NEW POD and SCREEN
945' N 1350' E CENTER 1/4 CORNER
SECTION 25, T38S R4W

ORIGINAL POD - 40' N 1610' E SW
CORNER SECTION 28, T38S R3W

◆ NEW POD METER
PIPELINES

C-30755 POU - 225 ACS TOTAL
170 ACS EAST OF MAP AREA
55 ACS SECTION 25

CLARIFIED ORIGINAL		
SW NE	26.5	8
(2 in LOT 5)		
SE NW	23	26
NE NW	1.5	---
SE NE	4	---
(2 in LOT 6)		
NE SW	---	6
NW SE	---	15

ParsonsWater Consulting LLC
rick.parsons@parsonswater.com
541.499.0257 303.667.5067

