


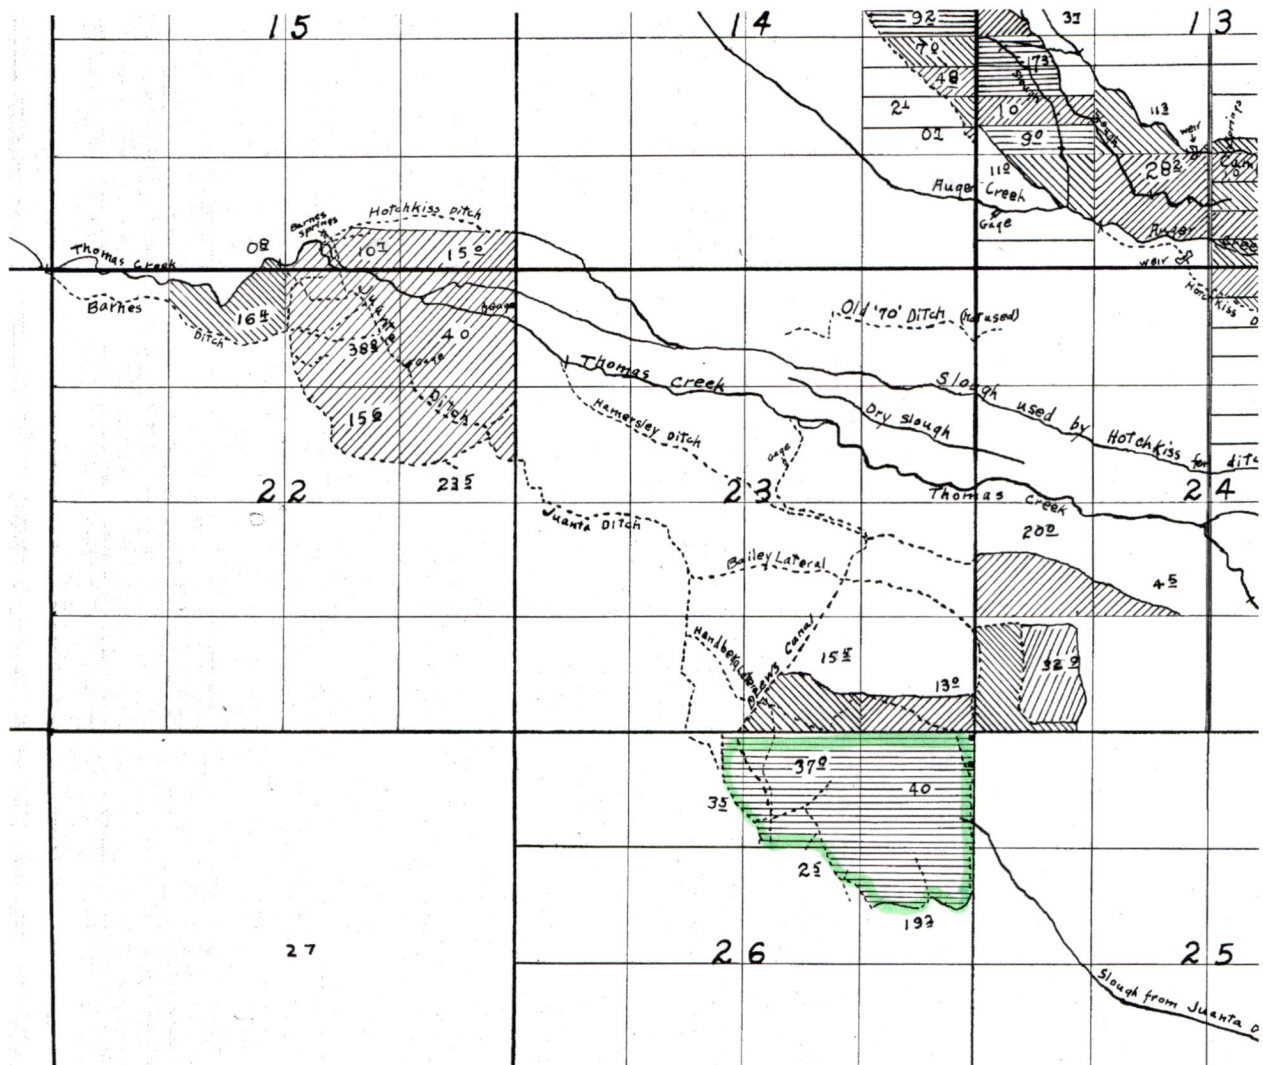

RECEIVED


JUN 04 2021

OWRD

13731

Robert & Teresa Squires Transfer Application Map Certificate 5245

T 38 S, R 19 E, WM
Section 26

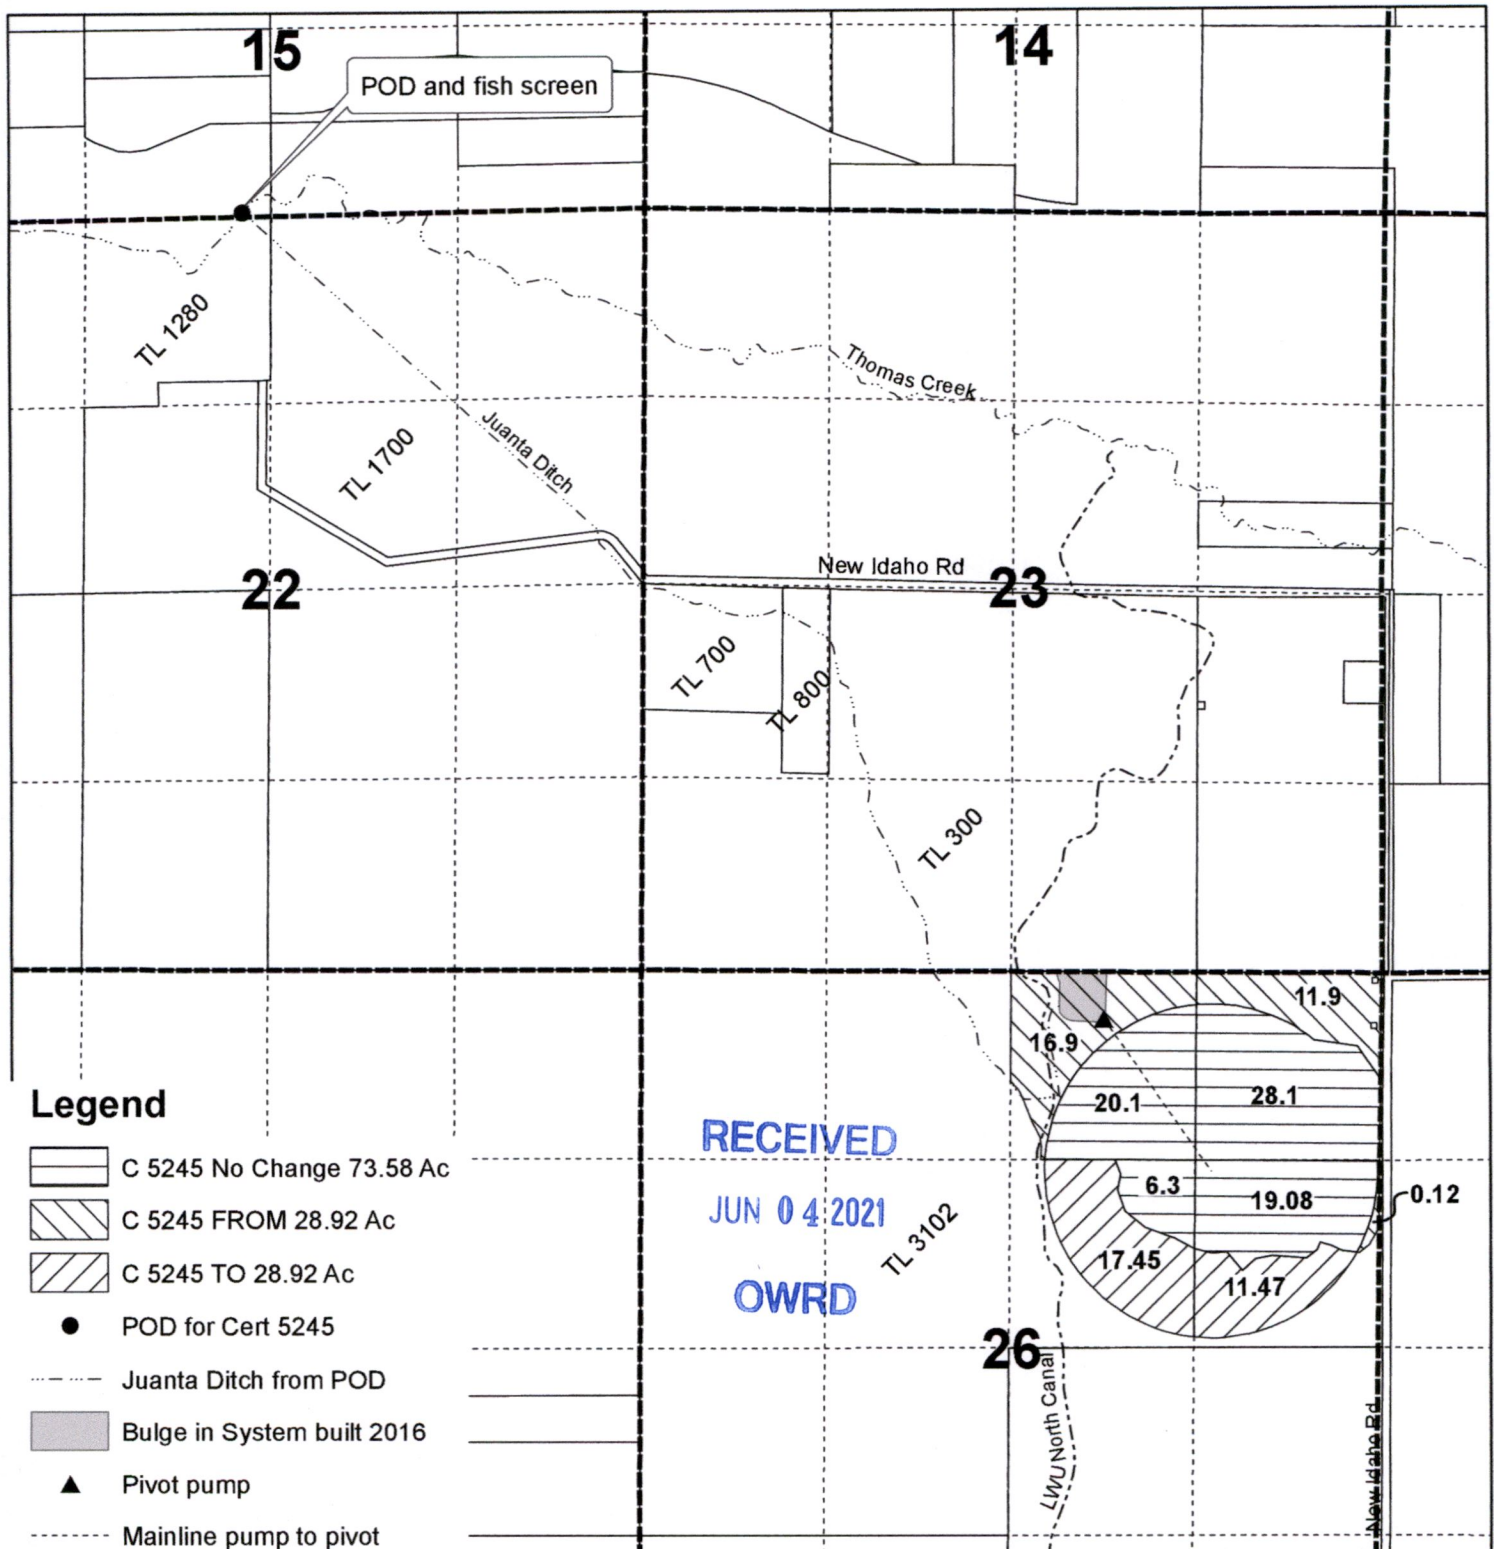

Legend

- C 5245 No Change 73.58 Ac
- C 5245 FROM 28.92 Ac
- C 5245 TO 28.92 Ac
- POD for Cert 5245
- Juanta Ditch from POD
- Bulge in System built 2016
- Pivot pump
- Mainline pump to pivot



1 inch = 1,320 feet

POD located in the
SESW of Sec 15
26.4 Ft North &
210.8 Ft West Fm
North 1/4 Cor of
Sec. 22, T38S, R19E

Note: This map is not
intended to provide
legal dimensions or
locations of property
ownership lines.



13731