


Boersma Family, LLC
Water Right Transfer Map
Certificate 20707

RECEIVED
T 38 S, R 11.5 E
Sec 24 & 25
FEB 01 2021 Map 1 of 4

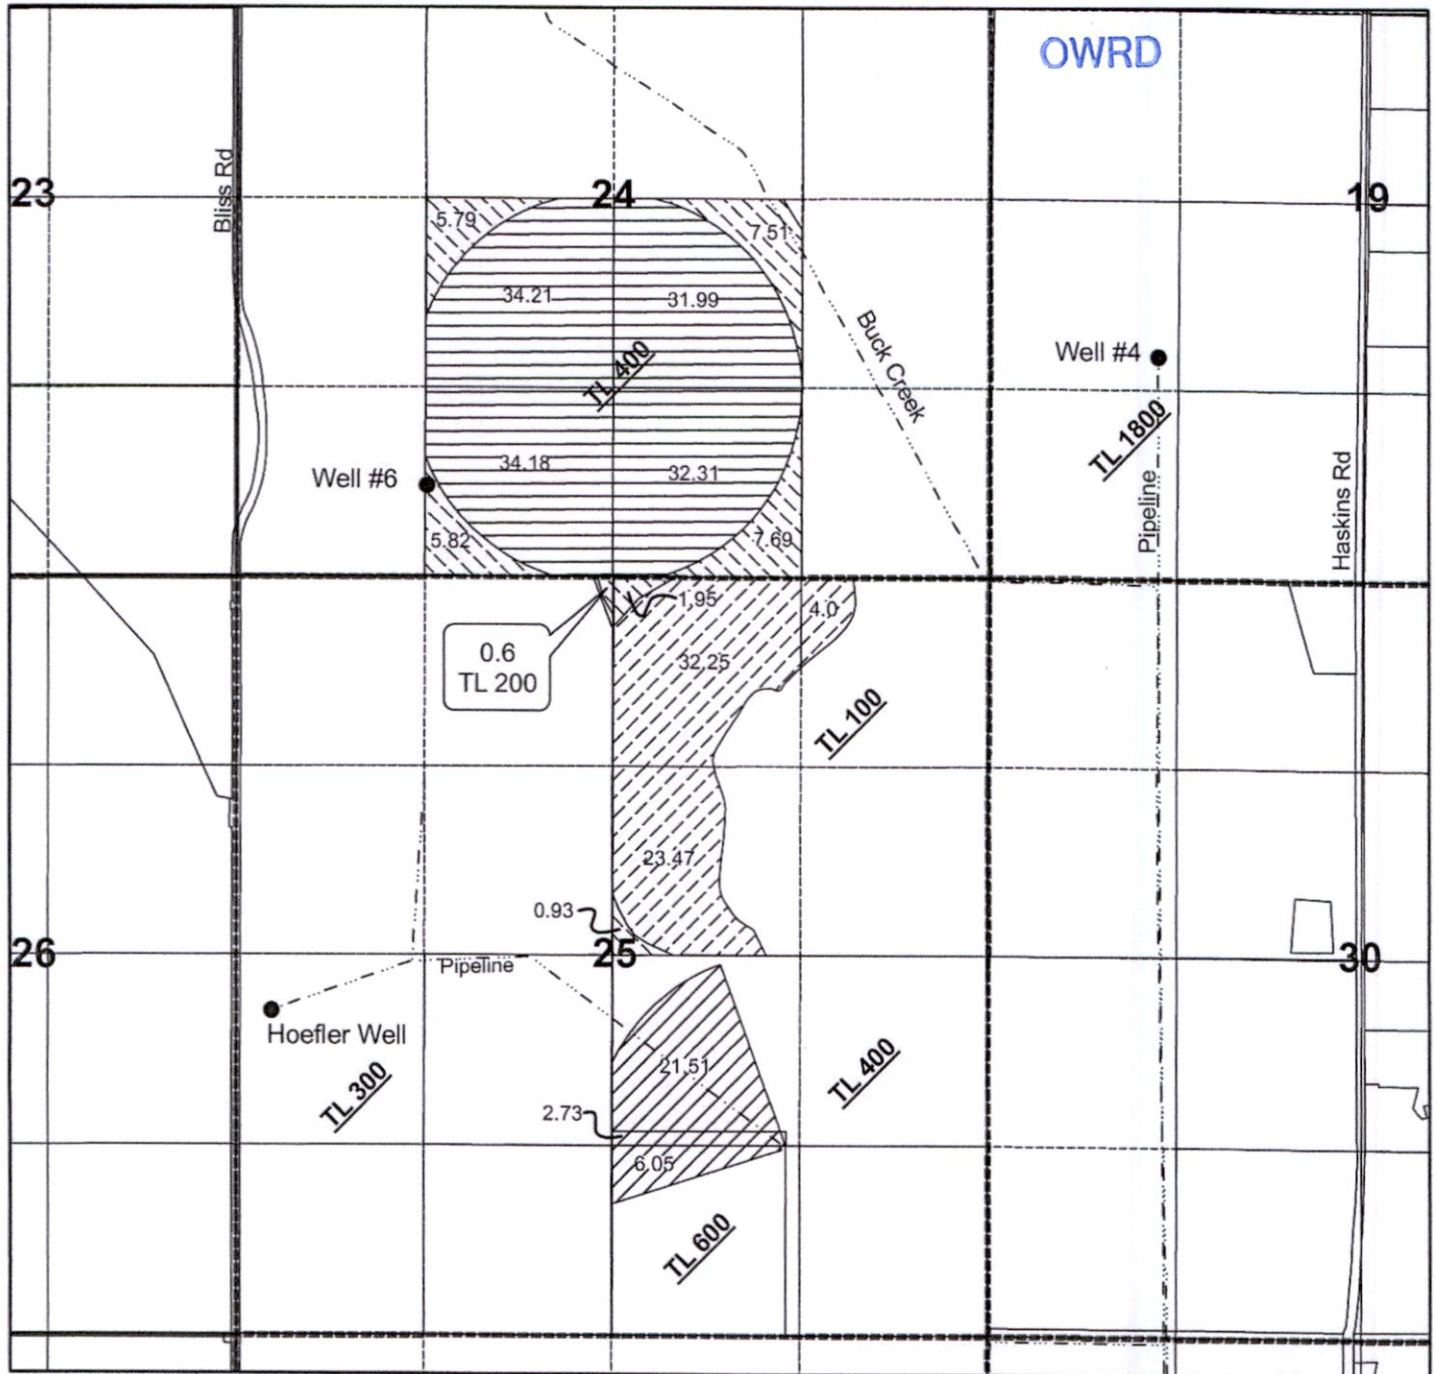

POA locations

Hoefler Well
2310 ft N & 250.8 ft E
From the SW Cor.
Sec 25, T38E, R11.5E


Well #4
1600 ft N & 1200 ft E
From the SW Cor.
Sec 19, T38S, R11E

Well #6
654.19 ft N & 1305.76 ft W
From the S 1/4 Cor
Sec 24, T38E, R11.5E

Legend

- POU No Change, use Well #4 59.72 ac
- No Change 132.69 ac
- Trans POU FROM 30.29 ac
- Trans TO & POA use Hoefler Well 30.29 ac

1 inch = 1,320 feet

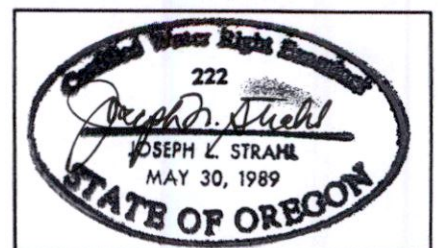


Note: This map is not intended to provide legal dimensions or locations of property ownership lines.

13811 -

T. 38S. R. 11 1/2 E. WM

Buck Creek & Yuma Valley weels

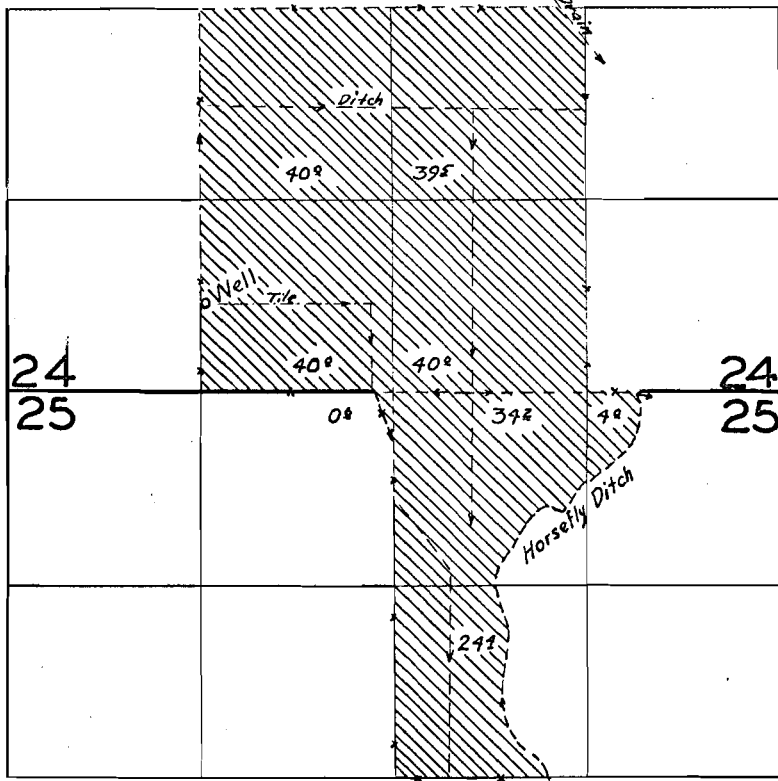

FINAL PROOF SURVEY
UNDER

Application No. U-311 Permit No. U-311

IN NAME OF

J. Luther, Nellie L., Laverna, and
Lorna Lee Haskins, as Haskins and Co.

Surveyed Aug. 9, 1953, by T. Jones