


RECEIVED

FEB 01 2021 T 38 S, R 11.5 E
Sec 25

OWRD

Map 2 of 4

Boersma Family, LLC Water Right Transfer Map Certificate 22851

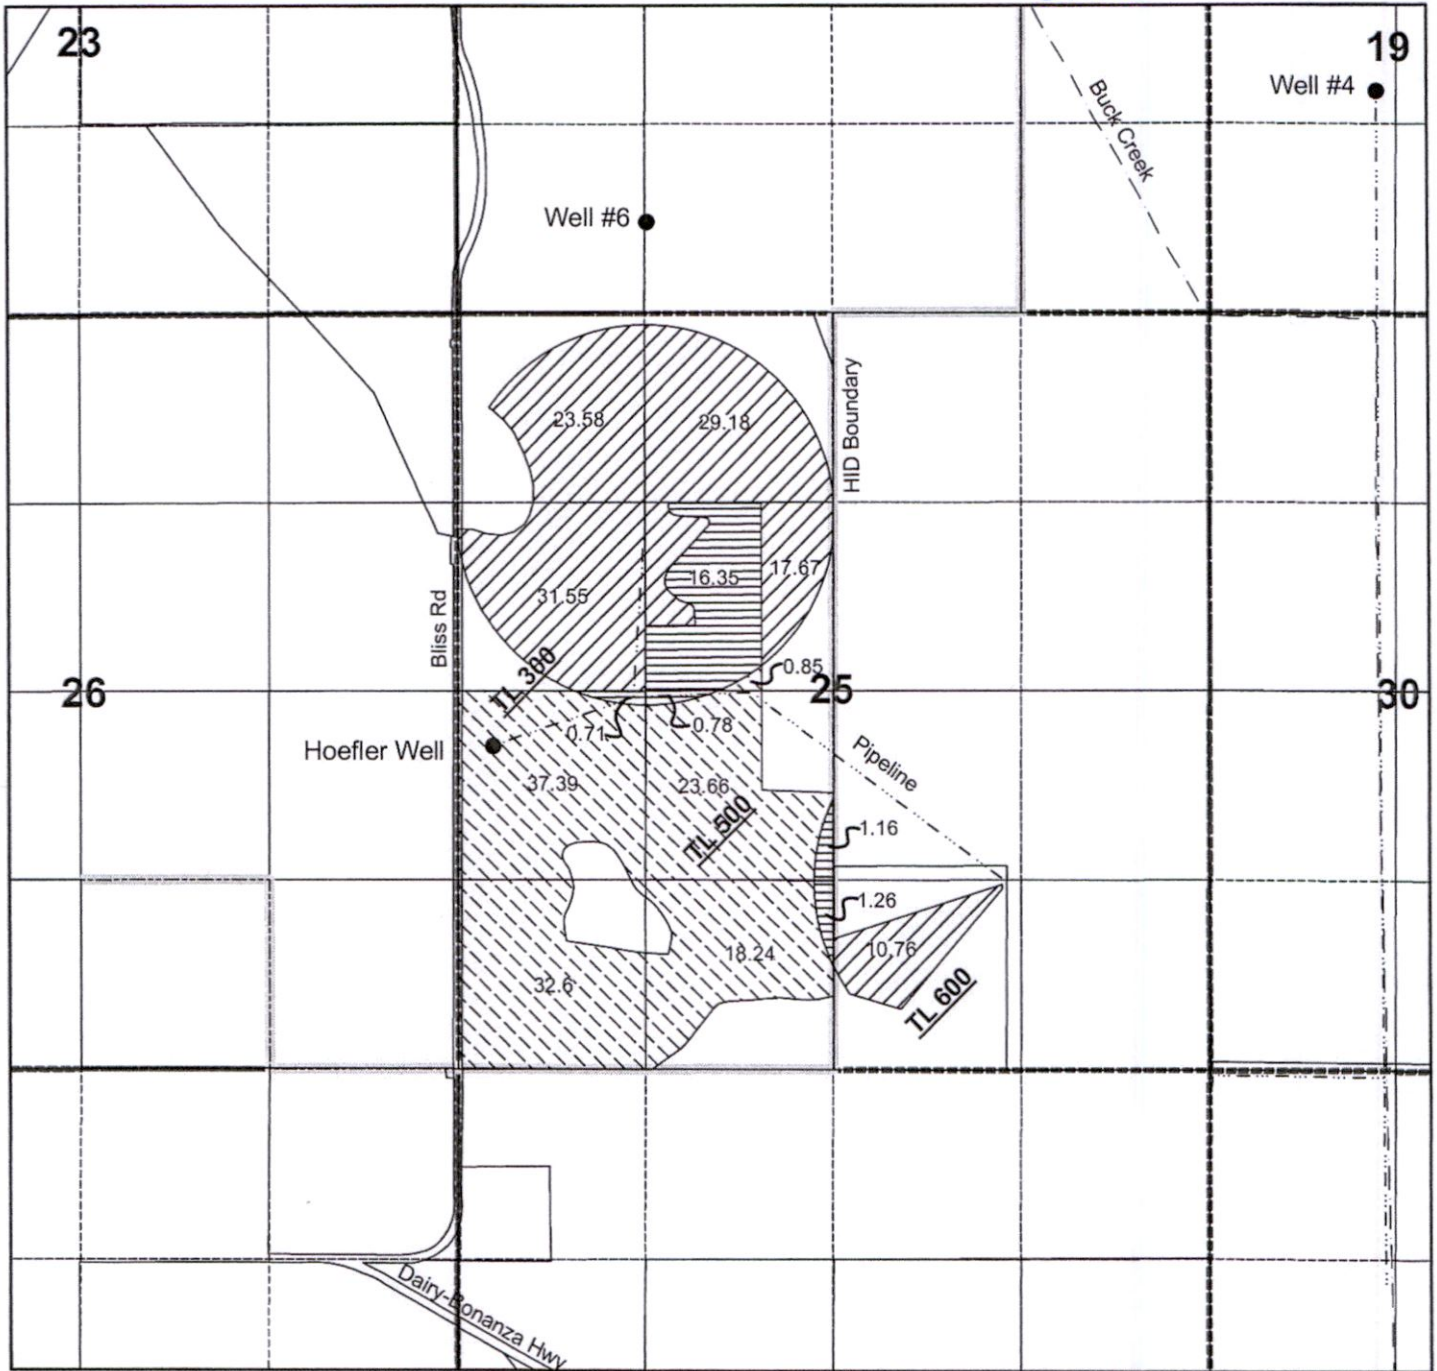

POA location


Hoefler Well
2310 ft N & 250.8 ft E
From the SW Cor.
Sec 25, T38E, R11.5E



1 inch = 1,320 feet

Legend


- Cert 22851 No Change 20.26 ac
- Cert 22851 FROM 112.74 ac
- Cert 22851 TO 112.74 ac

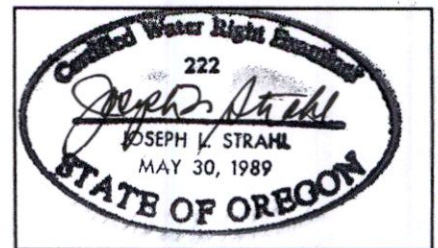

Note: This map is not intended to provide legal dimensions or locations of property ownership lines.

13611 -

T. 385, R. 11½ E.W.M.

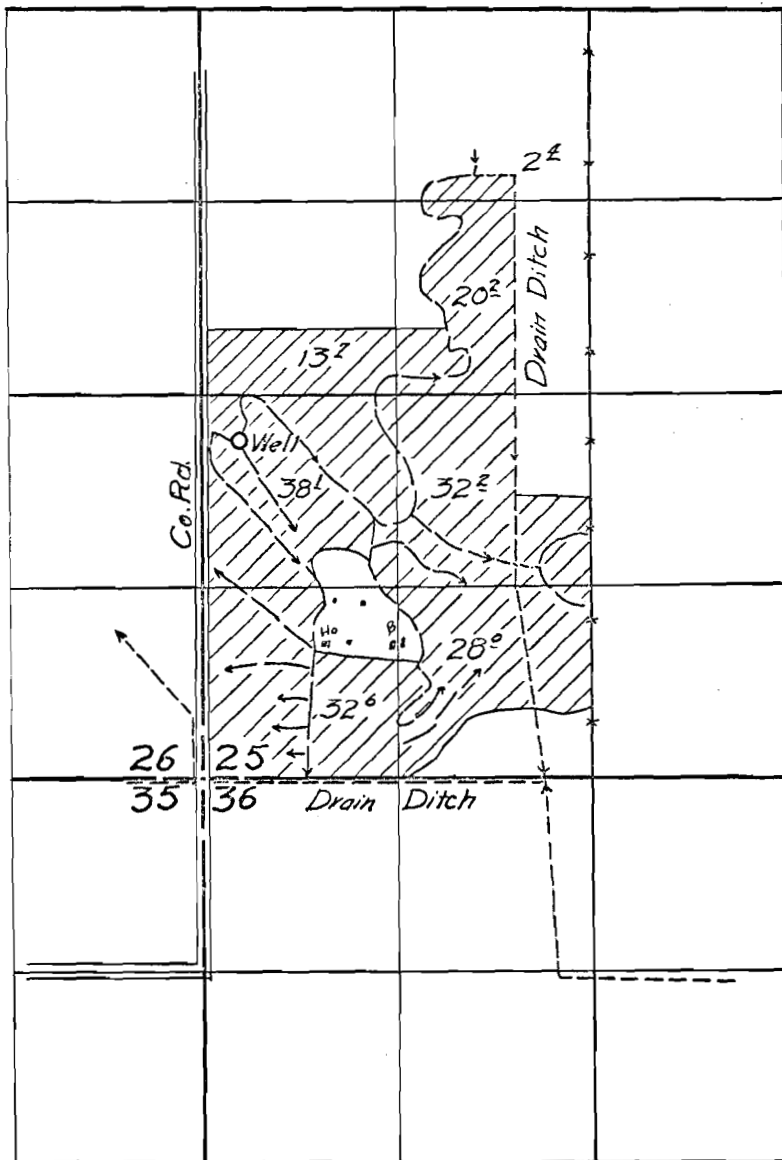

FINAL PROOF SURVEY
UNDER

Application No. U-316 Permit No. U-290
IN NAME OF

RICHARD HOEFLE

Surveyed 16 May.... 1955, by H.L. Coffman....