


Boersma Family, LLC
Water Right Transfer Map
Certificate 27209

T 38 S, R 11.5 E
Sec 25 & 36
Map 3 detail

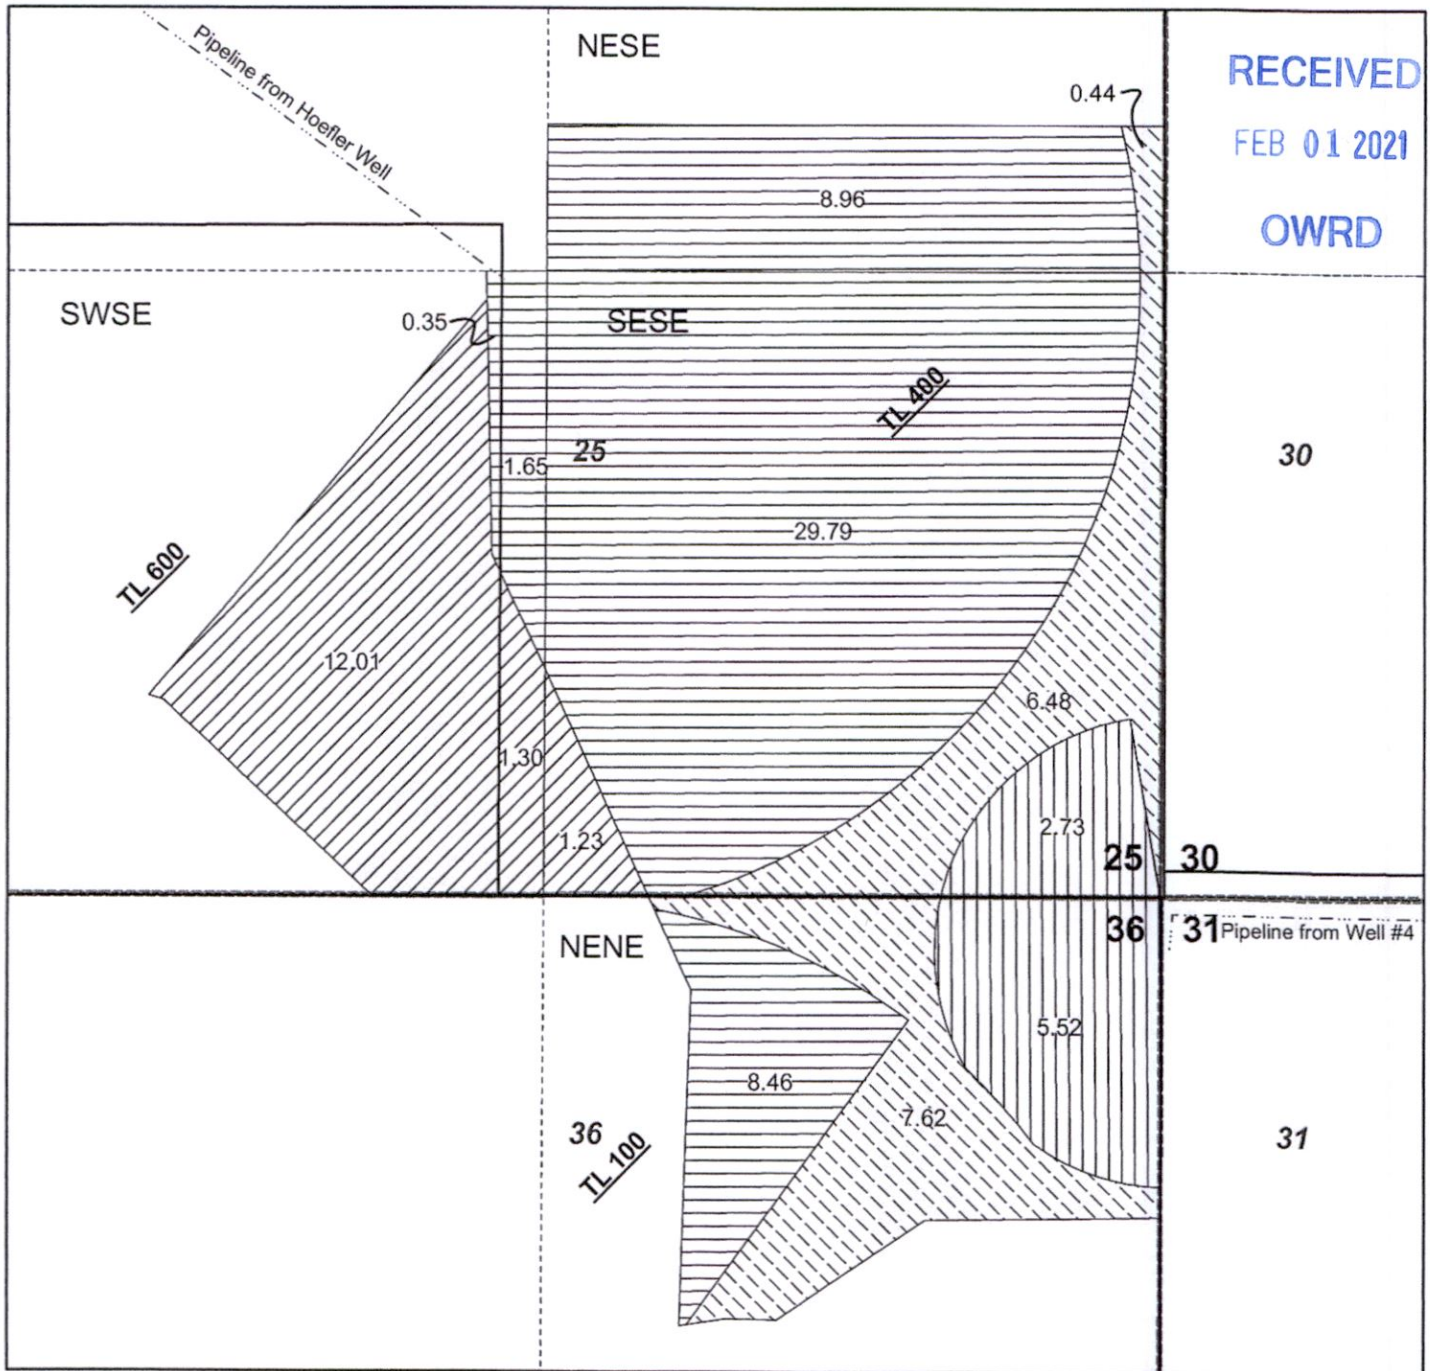

POA locations


Hoefler Well
 2310 ft N & 250.8 ft E
 From the SW Cor.
 Sec 25, T38E, R11.5E

Well #4
 1600 ft N & 1200 ft E
 From the SW Cor.
 Sec 19, T38S, R11E

Legend

1 inch = 400 feet

- Wells
- No Change 49.21 ac
- FROM POU only 14.54 ac
- TO POU only 14.54 ac
- Change POA to Well #4 8.25 ac

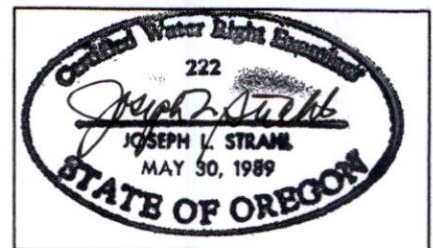

Note: This map is not intended to provide legal dimensions or locations of property ownership lines.

13811

Boersma Family, LLC
Water Right Transfer Map
Certificate 27209


RECEIVED

FEB 01 2021

T 38 S, R 11.5 E
 Sec 25 & 36

OWRD

Map 3 of 4

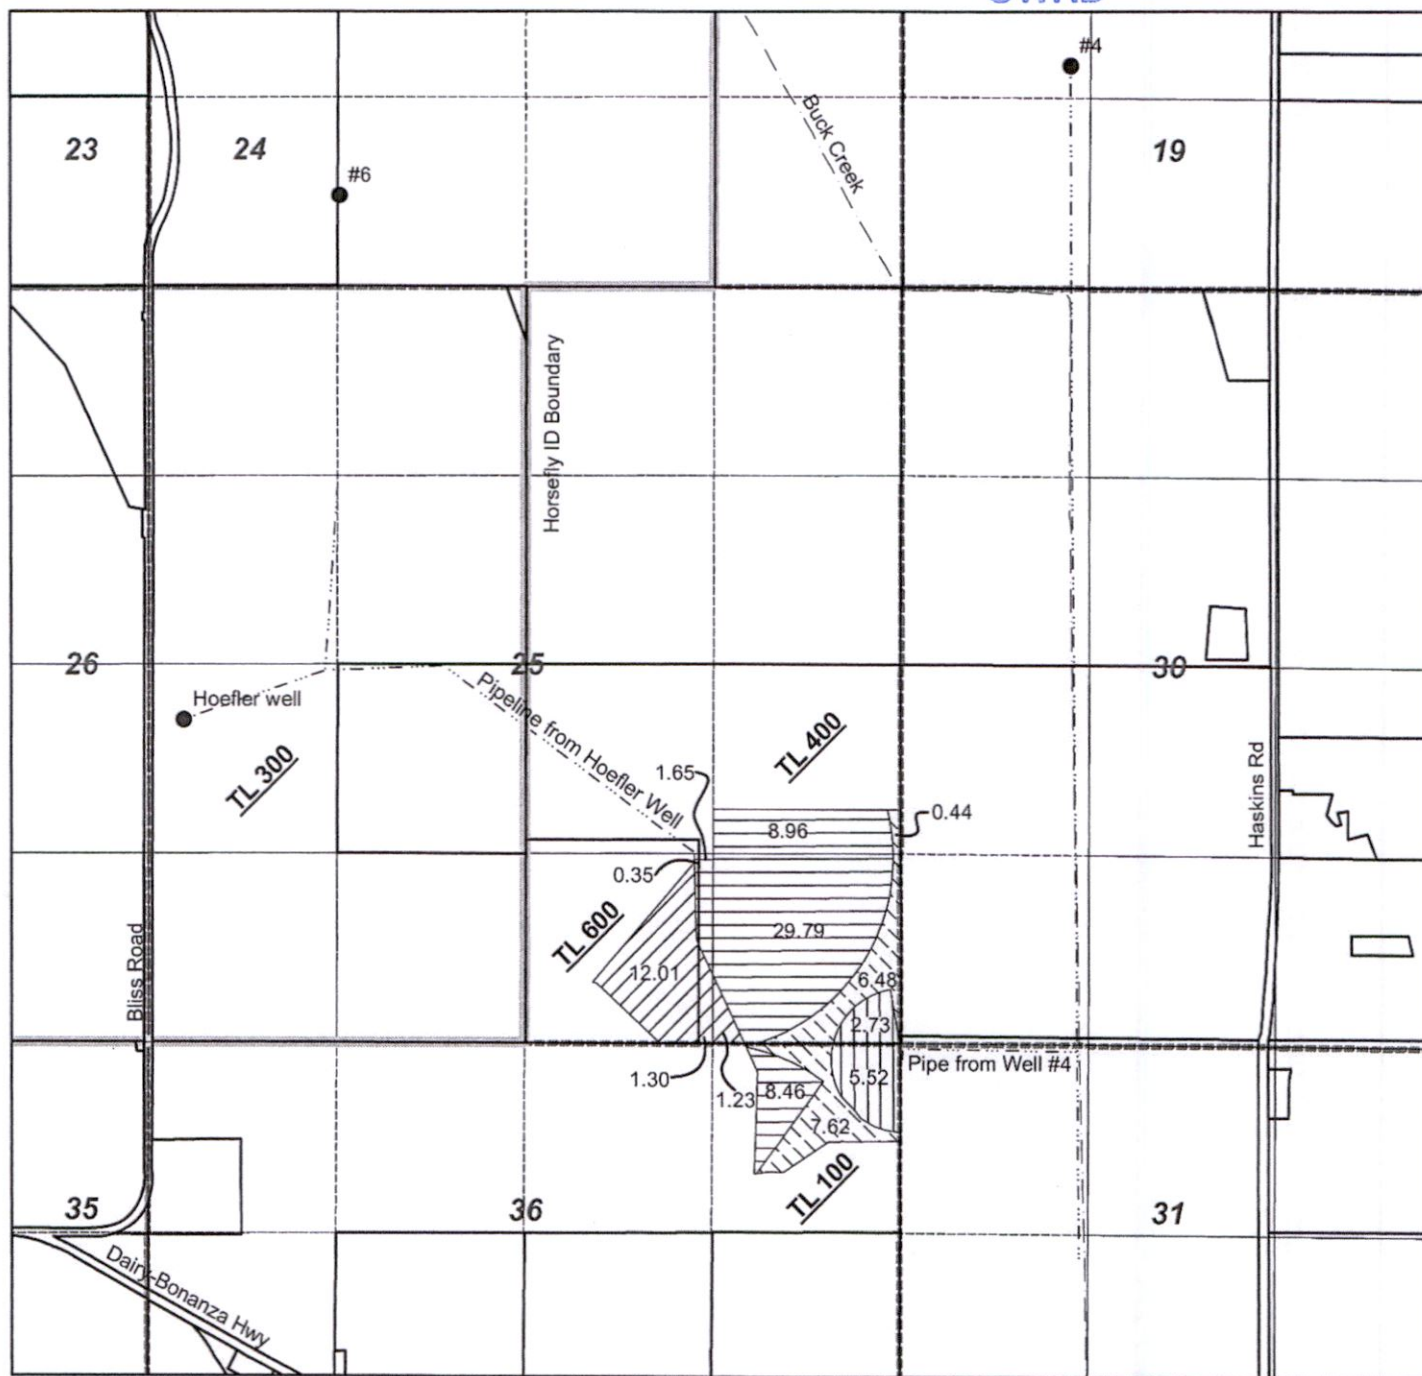

POA locations


1 inch = 1,320 feet

Hoefler Well
 2310 ft N & 250.8 ft E
 From the SW Cor.
 Sec 25, T38E, R11.5E

Well #4
 1600 ft N & 1200 ft E
 From the SW Cor.
 Sec 19, T38S, R11E

Legend

-  No Change 49.21 ac
-  FROM POU only 14.54 ac
-  TO POU only 14.54 ac
-  Change POA to Well #4 8.25 ac

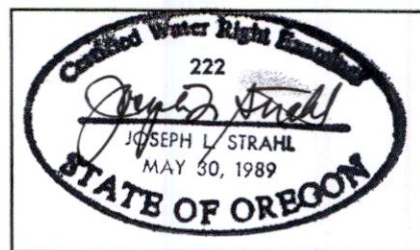

Note: This map is not intended to provide legal dimensions or locations of property ownership lines.

13611 -