


Boersma Family, LLC
Water Right Transfer Map
Certificate 40185

RECEIVED T 38 S, R 11.5 E
 FEB 01 2021 Sec 19 & 25
 Map 4 of 4


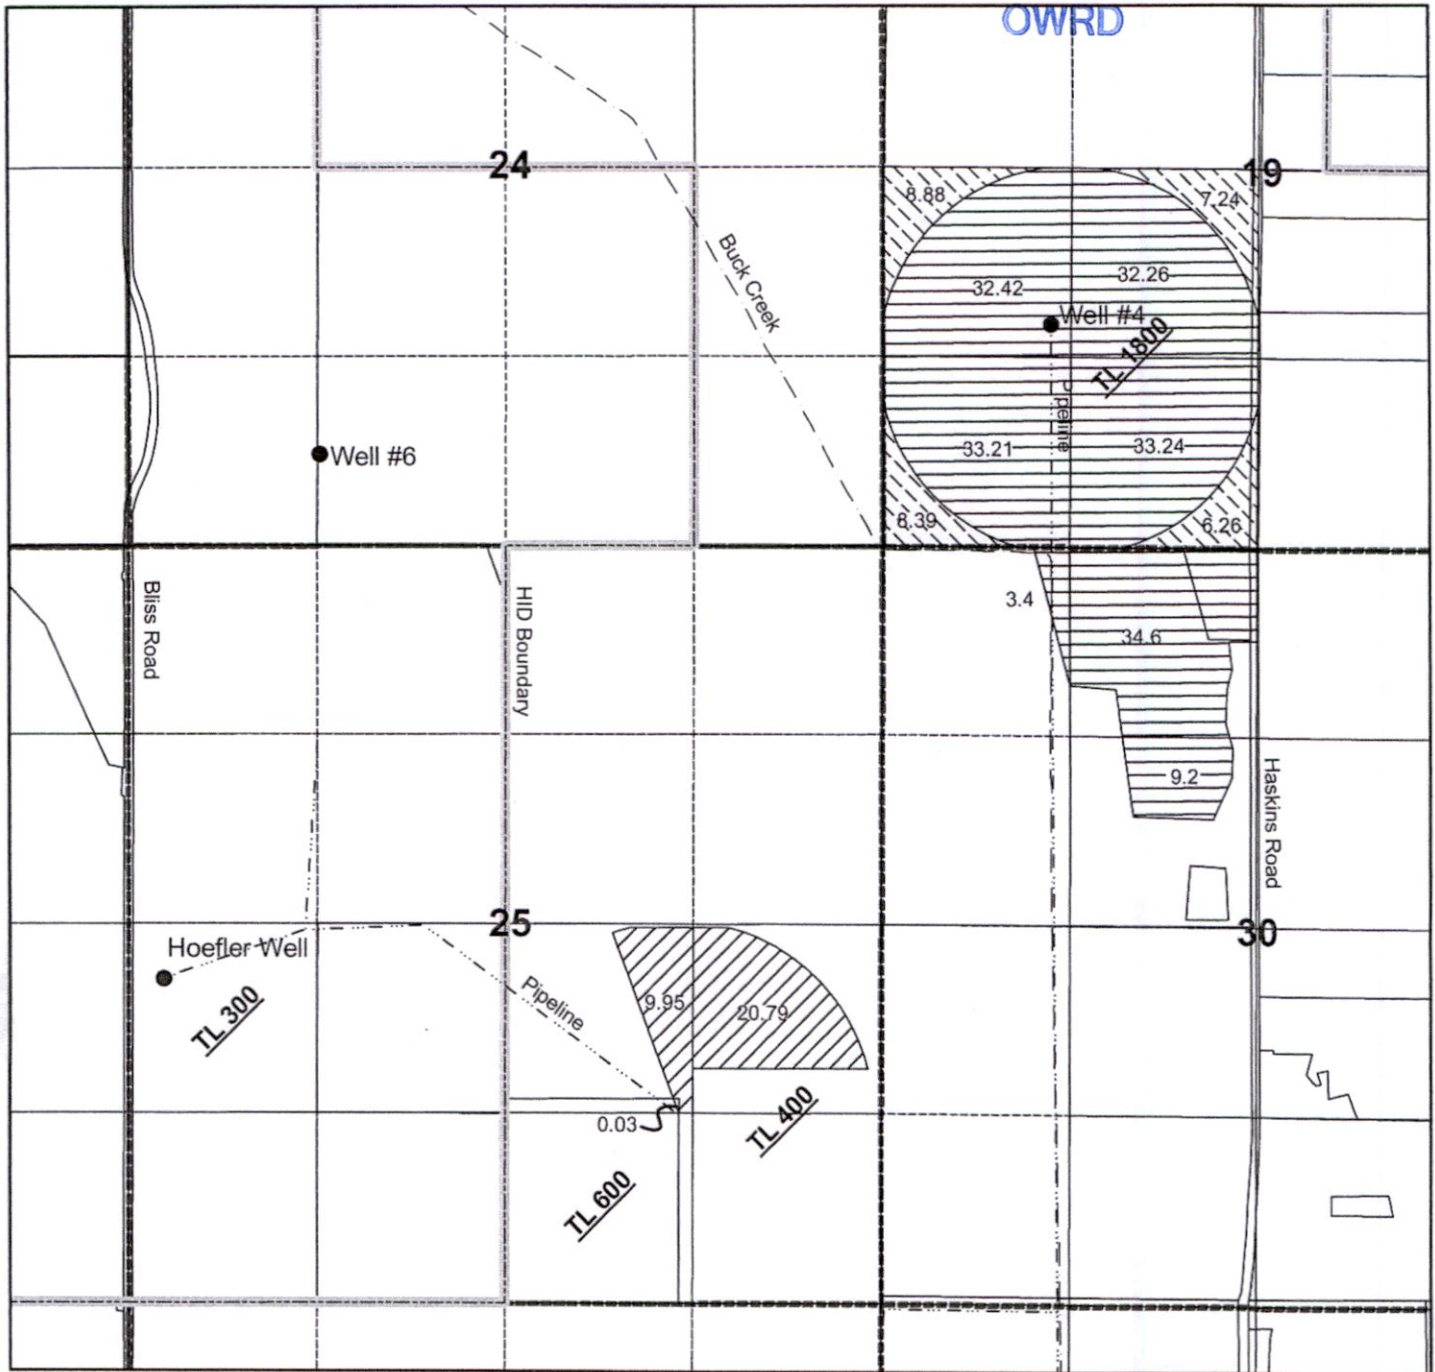



POA locations

Hoefer Well
 2310 ft N & 250.8 ft E
 From the SW Cor.
 Sec 25, T38E, R11.5E

Well #4
 1600 ft N & 1200 ft E
 From the SW Cor.
 Sec 19, T38S, R11E


Legend

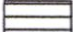 -  Cert 40185 No Change 178.33 ac
-  Cert 40185 FROM 30.77 ac
-  Cert 40185 TO & use Hoefer Well 30.77 ac



1 inch = 1,320 feet

13611

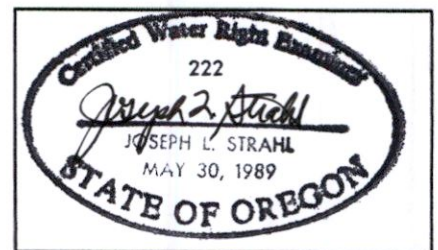


Note: This map is not intended to provide legal dimensions or locations of property ownership lines.

G-3443

40185

T.38S., R.11E., W.M.

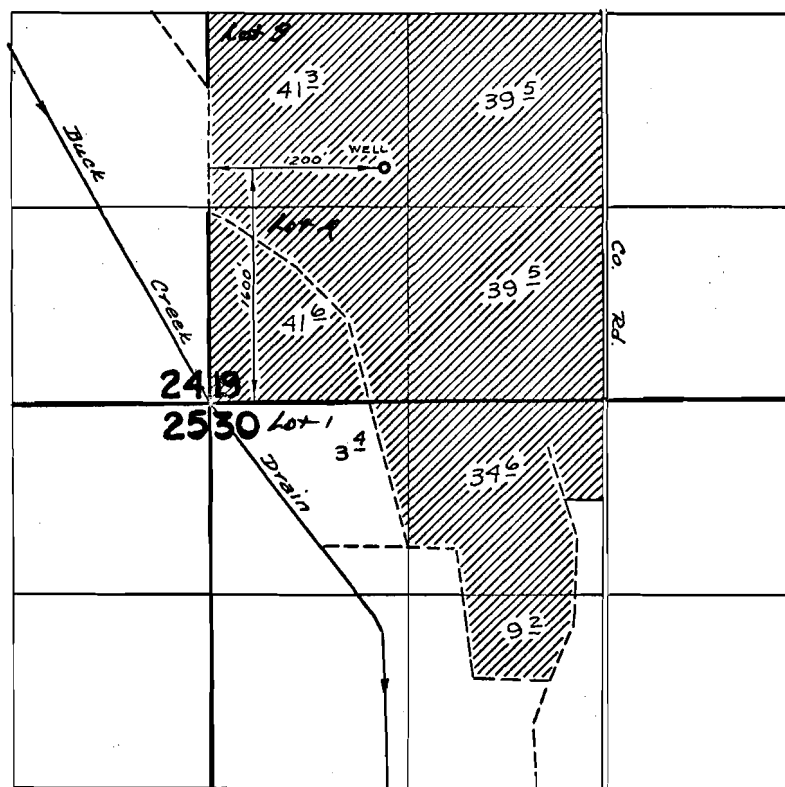

FINAL PROOF SURVEY
UNDER

Application No. G-3667 Permit No. G-3443
IN NAME OF

HASKINS And COMPANY, Inc.

Surveyed Oct. 18 1972, by D. Norby