


CLAIM OF BENEFICIAL USE M A P

Tax Lot 200; R-13455

Located in NW-SE & SW-SE of
of Section 9, T.11S., R.20E., W.M.
Wheeler County, Oregon

NOTES

1. This map was prepared for the purpose of identifying the location of water rights only and is not intended to provide legal dimensions or locations of property ownership lines.

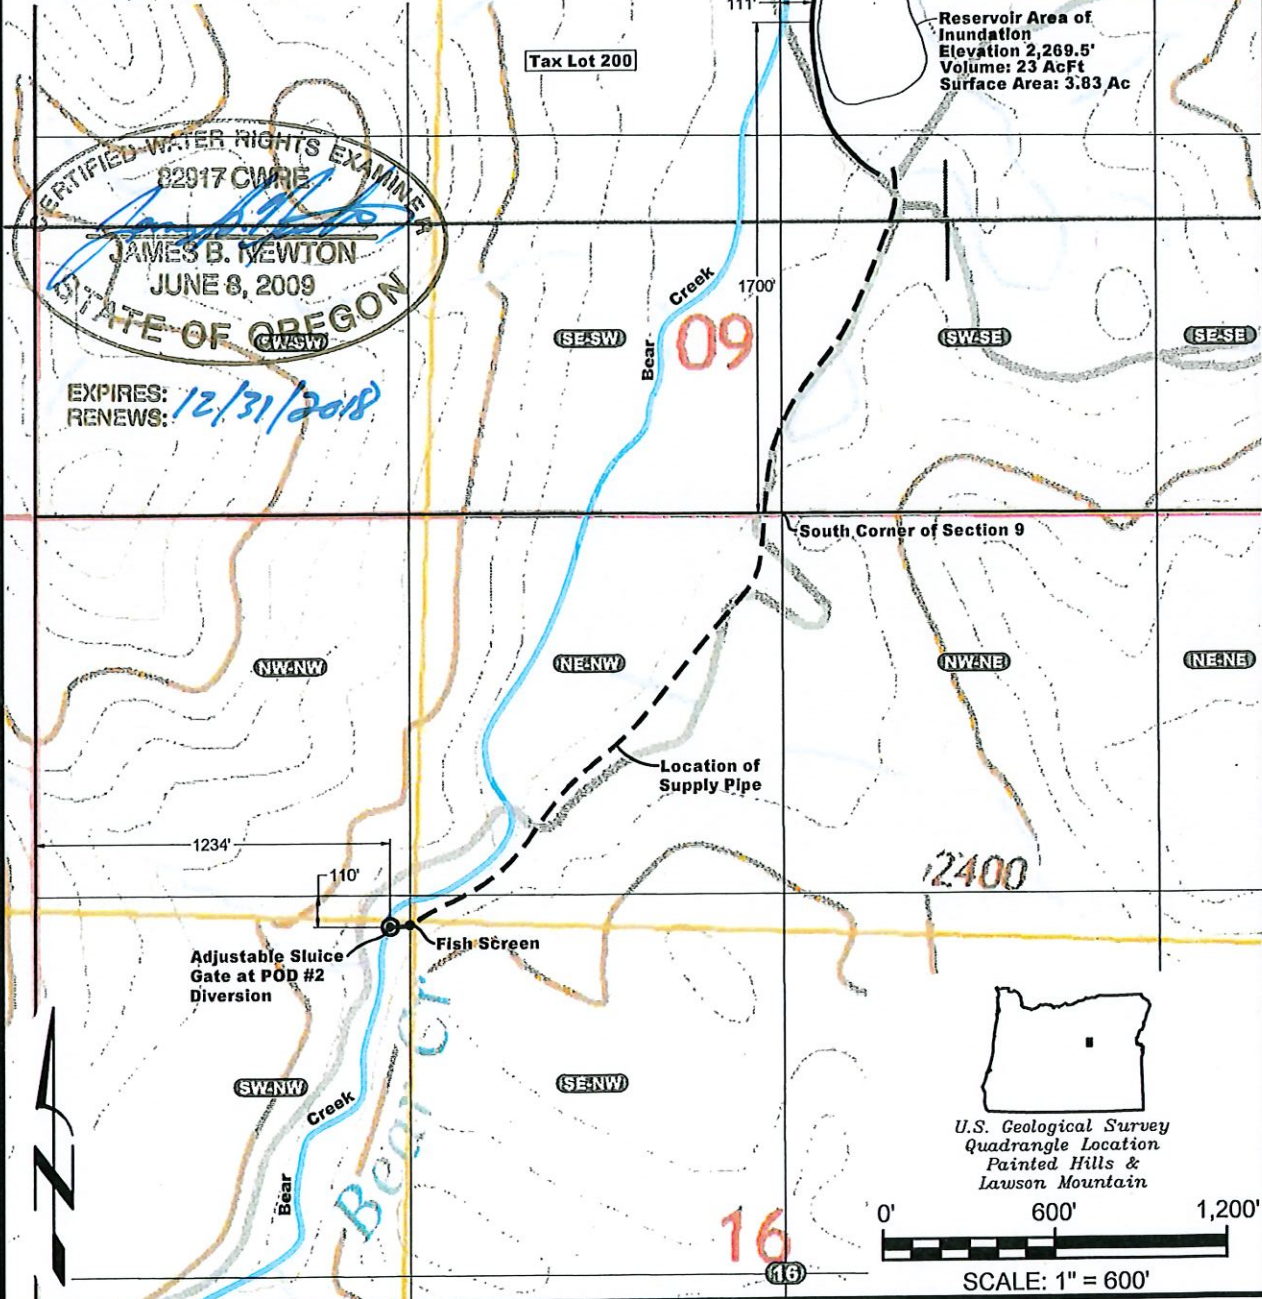

Claim of Beneficial Use Map - Long Reservoir
Storage in Long Reservoir; Permit R-13455
Wheeler County, Oregon

DESIGNED BY:
J. Newton

DRAWN BY:
R2D

DATE:
MAY 2017

PROJECT NO.
R-13455 COBU

FIGURE 3

RECEIVED BY OWRD

MAY 26 2017