


Claim of Beneficial Use
Application S-86450
Permit S-54506
S & F Land and Cattle
LX Ranch
Peter Ahart

T 39 S, R 24 E, WM
Section 23, 24, 25 & 26

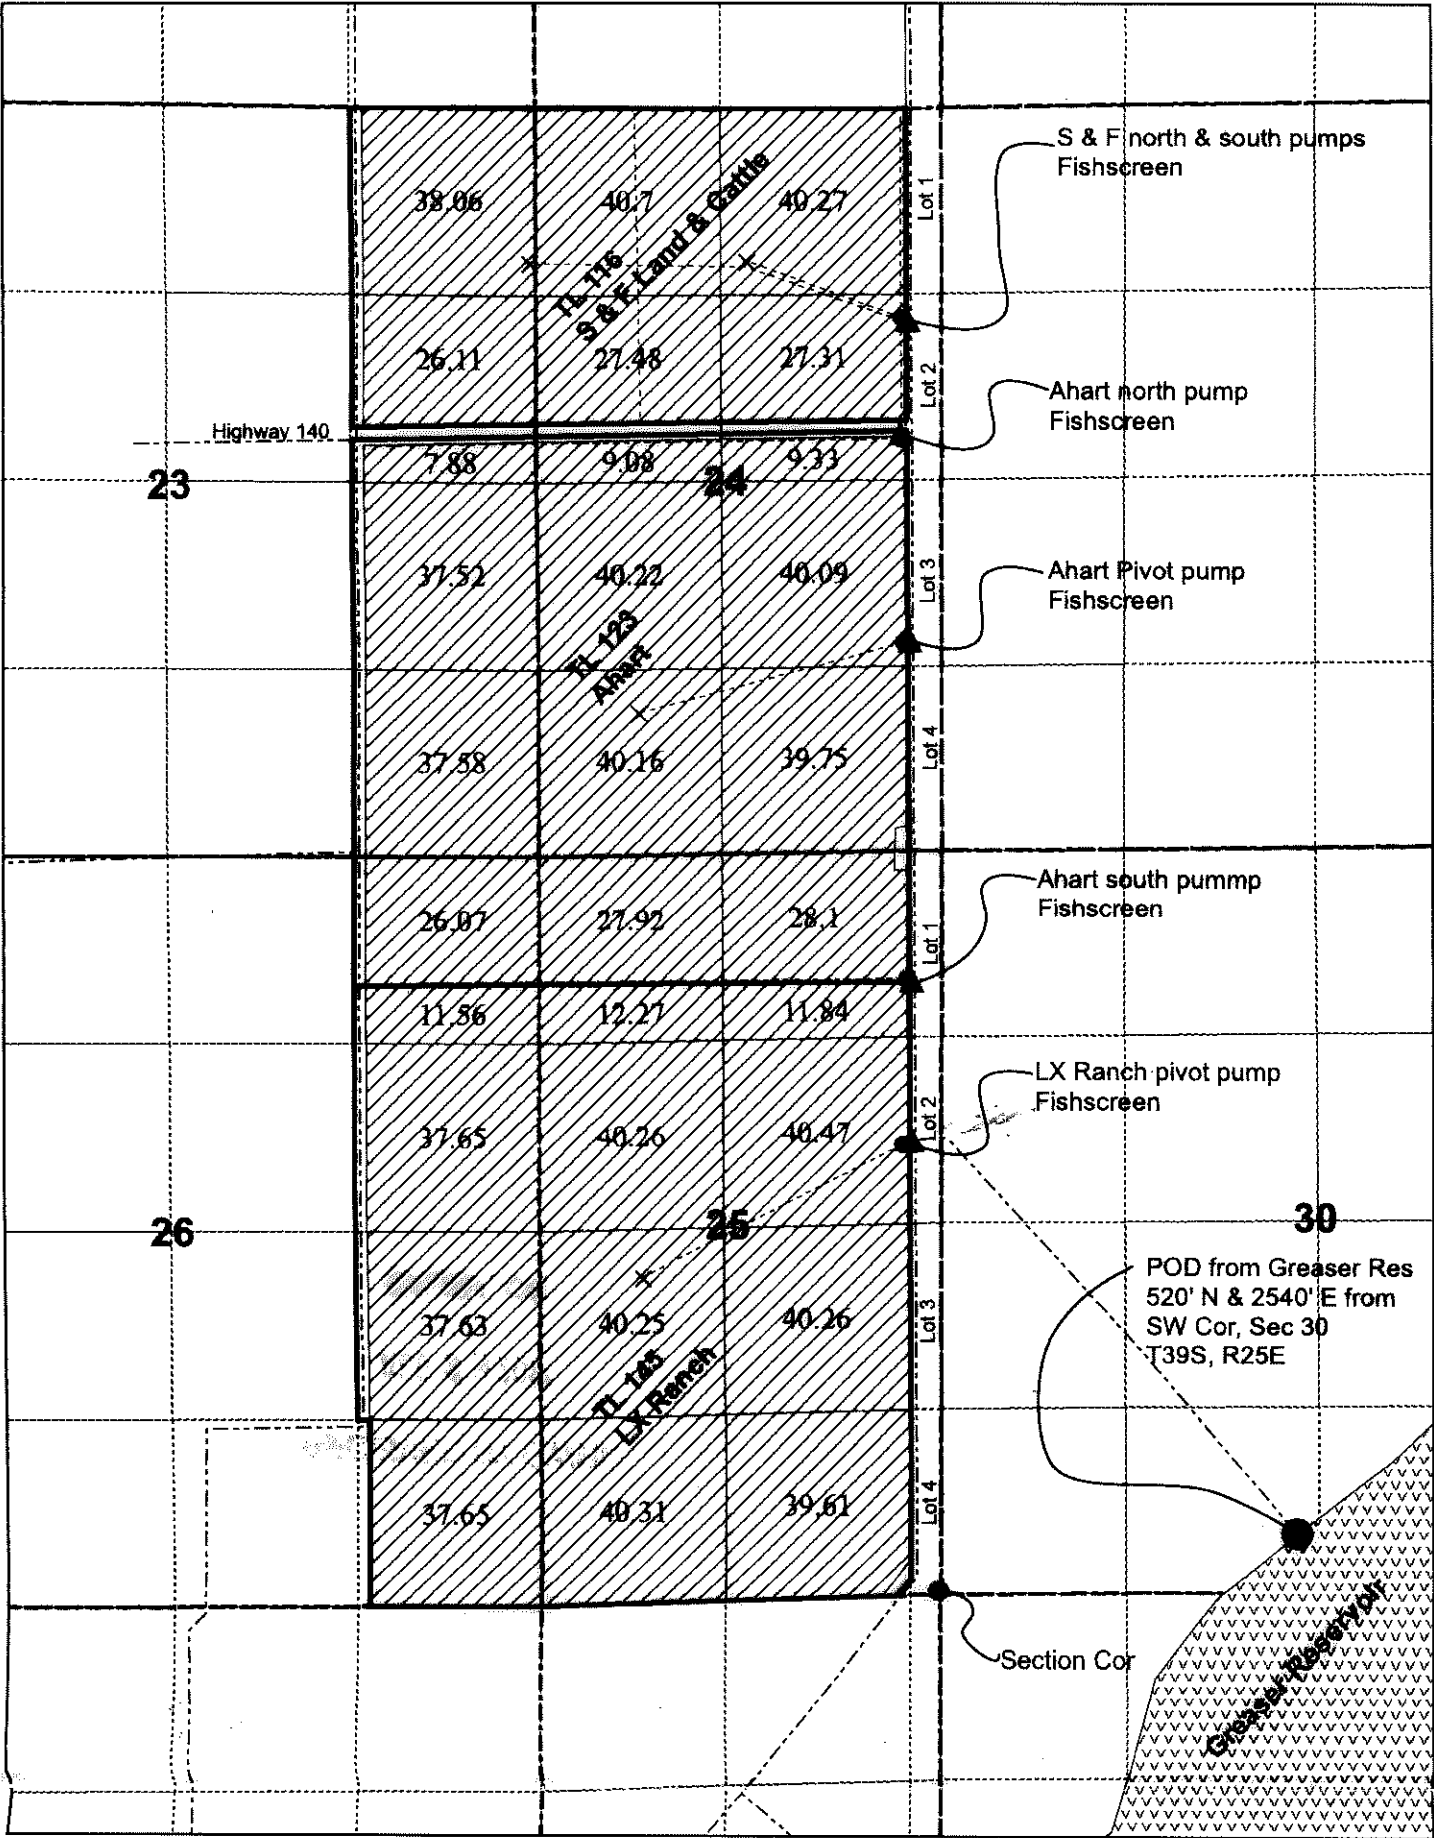

Legend

-  Area irrigated
-  Pump Station
-  Water Meter
-  Fish Screen
-  Canal
-  Pipeline



1 inch = 1,320 feet

Note: This map is not intended to provide legal dimensions or locations of property ownership lines.

