

LEGEND

- SECTION LINE
- 1/4 1/4 LINE
- TAX LOT LINE
- DITCH LINE
- PIPE
- ROAD
- SECTION CORNER
- TAX LOT NUMBER
- WELL
- IRRIGATED UNDER PERMIT G-13273
- IRRIGATED ACRES 1/4 1/4 SECTION


Greg L Harris
APPLICANT

WELL LOCATION

WELL 1 (KLAM 1090): T34S, R9E, SEC. 19, SE1/4 NE1/4; 1,430 FEET SOUTH AND 1,250 FEET WEST FROM NE CORNER, SECTION 19.

NOTES

1. THE PURPOSE OF THIS MAP IS TO IDENTIFY THE LOCATION OF THE WATER RIGHT ONLY, AND IS NOT INTENDED TO PROVIDE DIMENSIONS OR LOCATION OF PROPERTY LINES.
2. PRIORITY DATE FOR THIS WATER RIGHT IS SEPTEMBER 26, 1996.

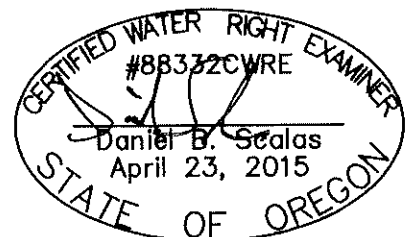

RENEWAL 06/30/22

AL ADKINS
ENGINEERING & SURVEYING

o / 541.884.4666
w / AdkinsEngineering.com

1435 ESPLANADE AVENUE, KLAMATH FALLS, OR 97601

SERVING S. OREGON & N. CALIFORNIA

ENGINEERING • SURVEYING • PLANNING • TESTING

2133-02

CLAIM OF BENEFICIAL USE MAP

FOR
GREG HARRIS
T34S, R9E, SEC. 19, WM
KLAMATH COUNTY, OREGON
PERMIT G-13273
APPLICATION G-14384

9/15/2020