


T17S., R1W., W.M. SECTION 32 & 33
MAP FOR GROUNDWATER POINT OF DIVERSION
DAN KINTIGH TAX LOTS: 100, 800, AND 1200
MAP # 1701324 & 170133
LANE COUNTY, OREGON
SEPTEMBER, 2021
APPLICATION G-16377, PERMIT G-16579

N

SCALE: 1" = 1320'

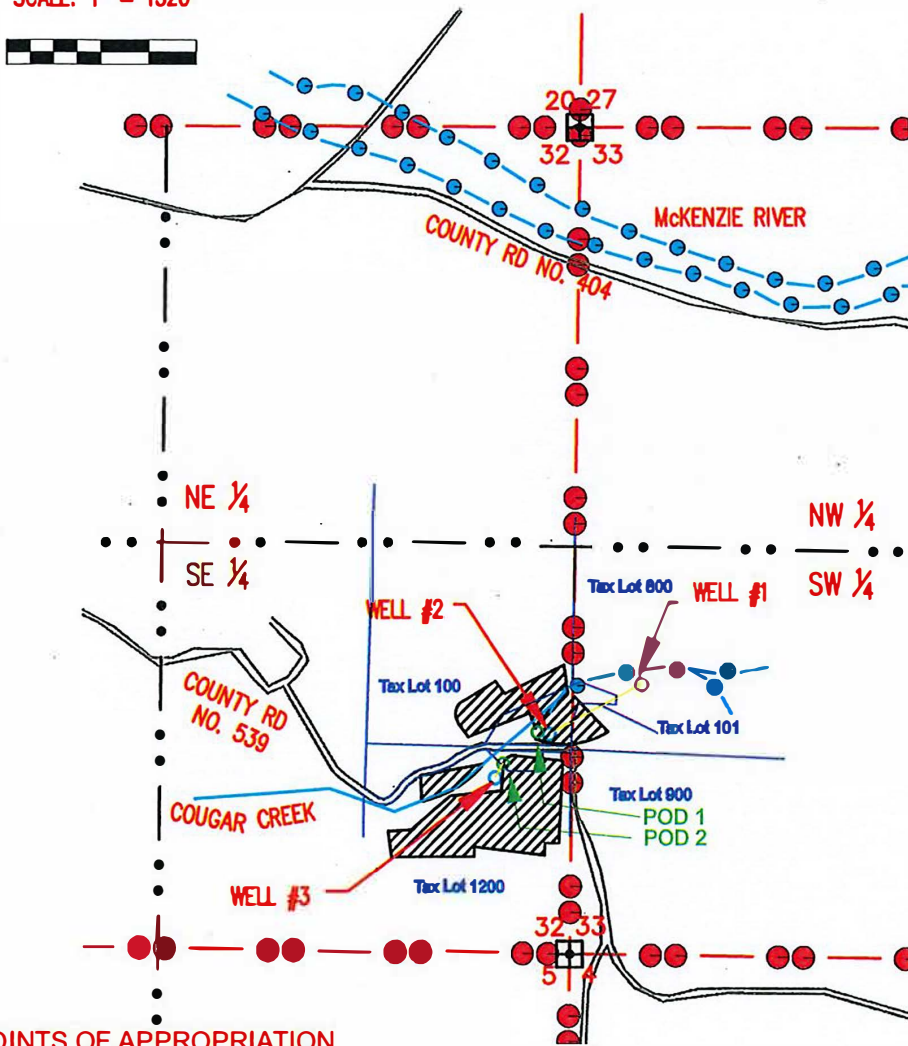

AREA OF USE BY QTR-QTR			
40	160	SECTION	ACRES
NE	SE	32	4.7
SE	SE	32	12.6
NW	SW	33	1.7



EXPIRATION DATE: 12/31/22

LEGEND

- SECTION LINE
- SECTION CORNER
- WELL
- ▨ AREA OF USE
- POINT OF DIVERSION (CERT 30977)
- TAX LOT LINE
- UNDERGROUND LINES

POINTS OF APPROPRIATION

WELL #1 AND METER

NW 1/4, SW 1/4
T17S., R1W., W.M. SECTION 33
1710' NORTH AND 475' EAST OF THE
SW CORNER OF SECTION 33

WELL #2 AND METER

NE 1/4, SE 1/4
T17S., R1W., W.M. SECTION 32
1400' NORTH AND 120' WEST OF THE
SE CORNER OF SECTION 32.

WELL #3 AND METER

SE 1/4, SE 1/4
T17S., R1W., W.M. SECTION 32
1120' NORTH AND 475' WEST OF THE
SE CORNER OF SECTION 32.

BASE MAPPING SUPPLIED BY LANE COUNTY
TAX MAPS 1701324 & 170133

THIS MAP IS NOT INTENDED TO PROVIDE
LEGAL DIMENSIONS OR LOCATIONS OF
PROPERTY OWNERSHIP LINES

AREA OF USE

4.7 ACRES, NE 1/4, SE 1/4 OF SECTION 32
12.6 ACRES, SE 1/4, SE 1/4 OF SECTION 32
1.7 ACRES NW 1/4, SW 1/4 OF SECTION 33

RECEIVED

OCT 15 2021

OWRD



EGR & Associates, Inc.
Engineers, Geologists and Surveyors
2535 B Prairie Road
Phone (541) 688-8322
FAX (541) 688-8087