
T4S, R3W WM, Sections 29, 30, 31, 32 Yamhill County, Oregon Application S-88187 Permit S-55014

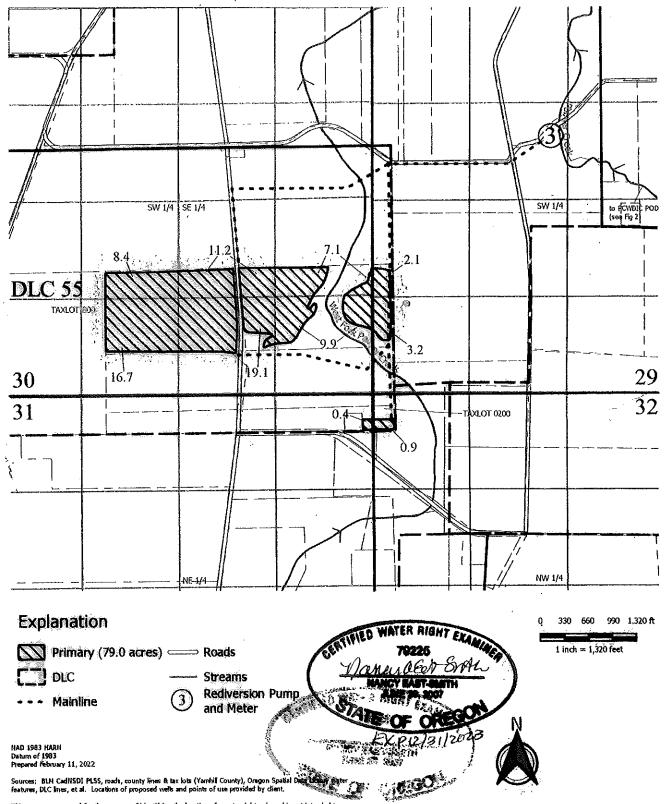

This map was prepared for the purpose of identifying the location of a water right only and is not intended to provide legal dimensions or locations of property ownership lines.




CLAIM OF BENEFICIAL USE


Map 1 of 2 - Place of Use

Palmer Creek Water District Company


T6S, R3W WM, Section 4 Yamhill County, Oregon Application S-88187 Permit S-55014

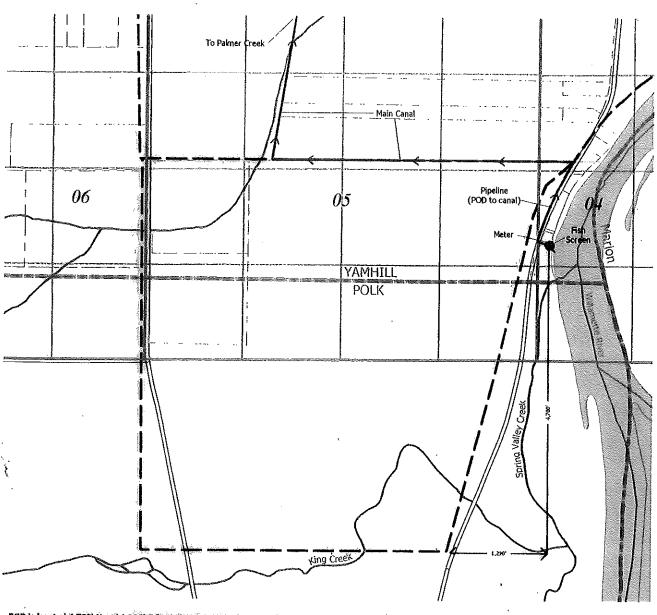

POD is located 4,700' H and 1,290' E from the SE corner of DLC 58, T6S, R3W, Sec. 4, NW 1/4 SW1/4

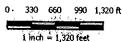

Explanation

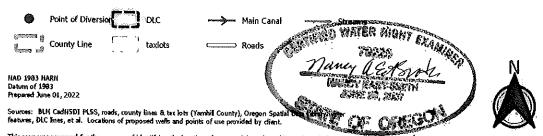

This map was prepared for the purpose of identifying the location of a water right only and is not intended to EX P12/21/2023 provide legal dimensions or locations of property ownership lines.



CLAIM OF BENEFICIAL USE

Map 2 of 2

Palmer Creek Water District Company